



FILED  
 GREENVILLE CO. S.C.  
 NOV 5 12 16 PM '84  
 DONNIE S. WATERSLEY  
 R.M.C.

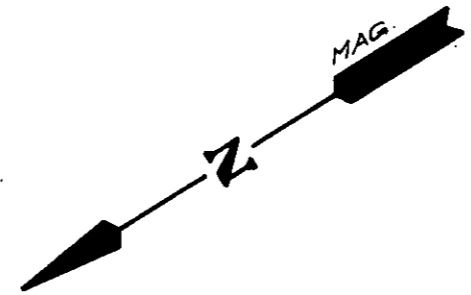


NOTE: 5' DRAINAGE & UTILITY EASEMENT  
 ALONG EACH SIDE OF ALL SIDE  
 & REAR LOT LINES.

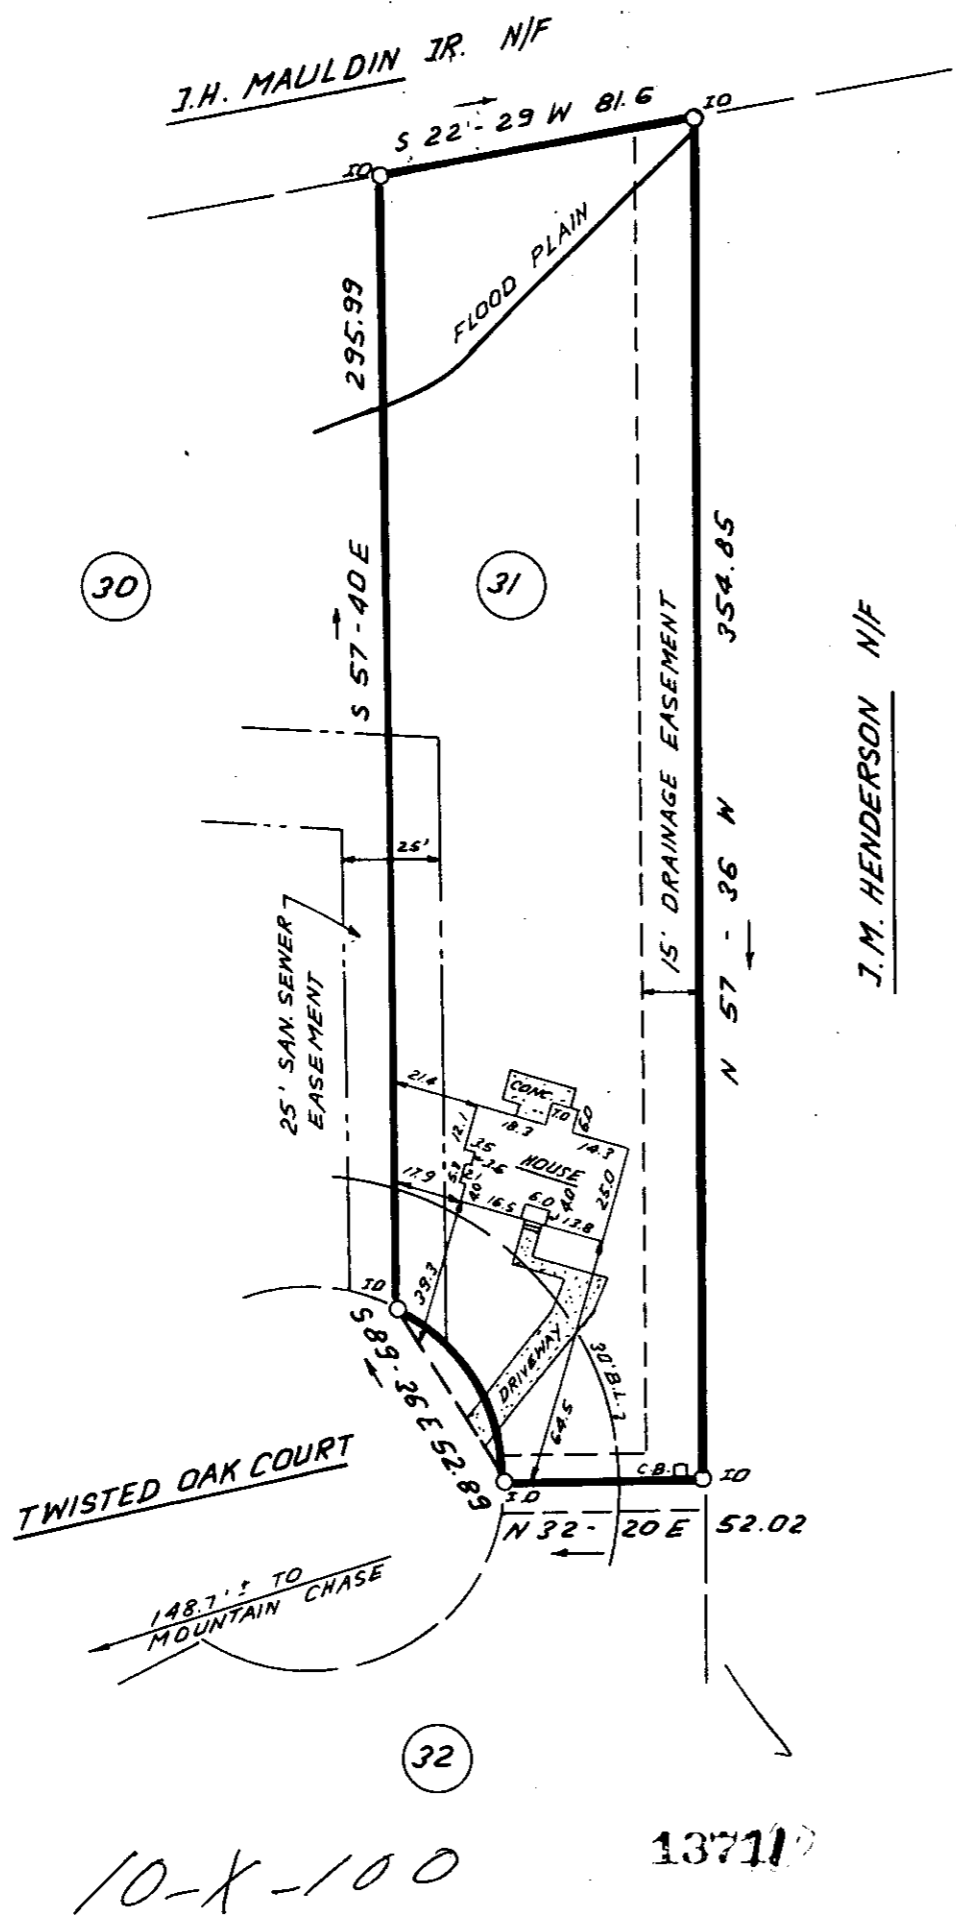

THIS IS TO CERTIFY THAT THE PROPERTY SHOWN ON THIS PLAT WAS SURVEYED UNDER MY DIRECT SUPERVISION. PROPERTY LINES AND IMPROVEMENTS SHOWN ARE LOCATED CORRECTLY AND THAT NO VISIBLE ENCROACHMENTS EXIST UNLESS OTHERWISE SHOWN. THIS HOUSE IS NOT LOCATED IN A DESIGNATED FLOOD HAZARD AREA.

TWISTED OAK COURT  
 148.7' TO MOUNTAIN CHASE

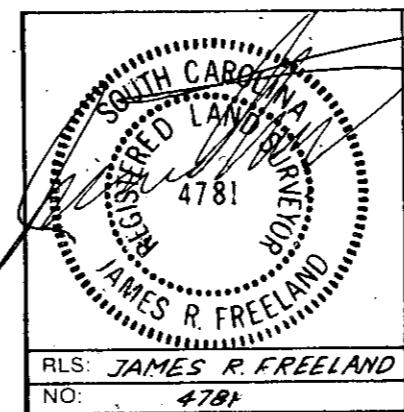

STATE OF SOUTH CAROLINA  
 GREENVILLE COUNTY

FREELAND & ASSOCIATES  
 Engineers • Land Surveyors  
 318 WEST STONE AVENUE,  
 GREENVILLE, S.C.  
 (803) 271-4924

MOUNTAIN CREEK  
 PHASE 2, LOT 31  
 PROPERTY OF  
 MARIA B. WARD

PLAT BOOK	9 F @ 4
DEED BOOK	
TAX MAP	
PARTY CHIEF	R. J.
DRAWN	I. R.
DATE	10-29-84
DWG. NO.	11978

RLS: JAMES R. FREELAND  
 NO: 4781

10-X-100

13711

500 3  
 THE PRINT MACHINE, INC.  
 2140 1/2

MICROFILMED