



MICROFILMED

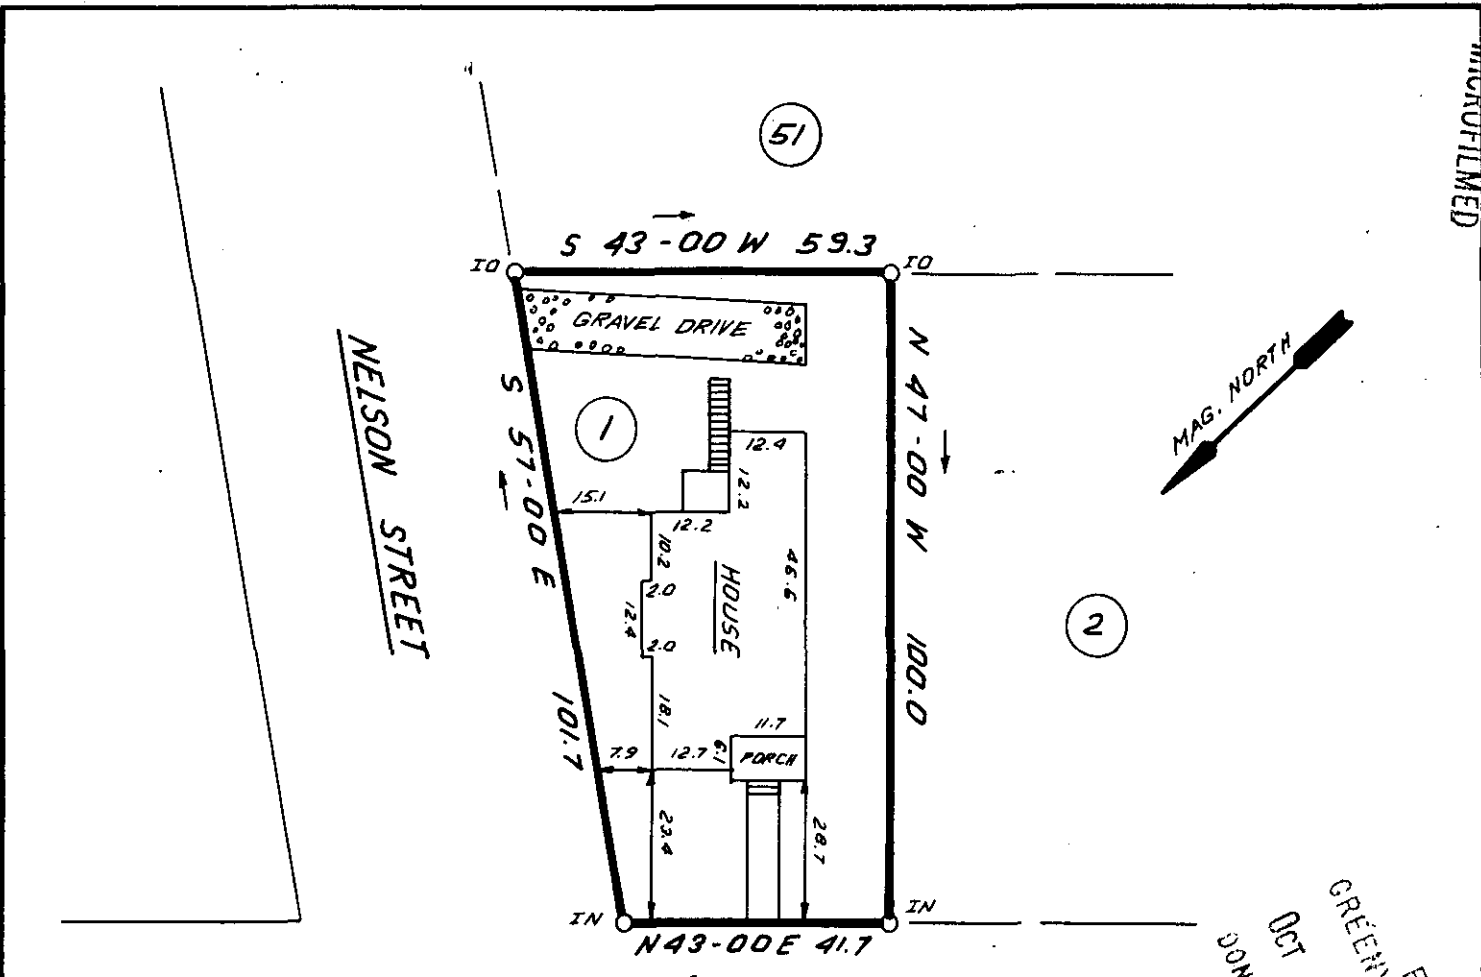

FILED  
 GREENVILLE CO. S.C.  
 OCT 1 2 26 PM '84  
 DONNIE S. JANKERSLEY  
 R.M.C.

10-y-64 10032

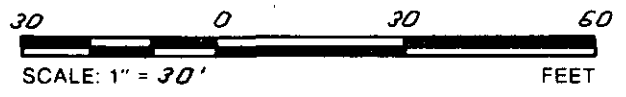

OCT 1 1984

THIS IS TO CERTIFY THAT THE PROPERTY SHOWN ON THIS PLAT WAS SURVEYED UNDER MY DIRECT SUPERVISION. PROPERTY LINES AND IMPROVEMENTS SHOWN ARE LOCATED CORRECTLY AND THAT NO VISIBLE ENCROACHMENTS EXIST UNLESS OTHERWISE SHOWN. THIS PROPERTY IS NOT LOCATED IN A DESIGNATED FLOOD HAZARD AREA.

**STATE OF SOUTH CAROLINA  
 GREENVILLE COUNTY**

**FREELAND & ASSOCIATES**  
 Engineers • Land Surveyors  
 318 WEST STONE AVENUE.  
 GREENVILLE, S.C.  
 (803) 271-4924

WASHINGTON HEIGHTS  
LOT 1  
PROPERTY OF  
EDWARD J. WATKINS

PLAT BOOK	F-53-54
DEED BOOK	
TAX MAP	26-500/95-6-1
PARTY CHIEF	J.E.C.
DRAWN	I.R.
DATE	9-26-84
DWG. NO.	118/5

SOUTH CAROLINA  
 REGISTERED LAND SURVEYOR  
 4781  
 JAMES R. FREELAND

RLS: JAMES R. FREELAND  
 NO: 4781

GCTG -- 100.184 119

3.001