


MICROFILMED

FILED  
GREENVILLE CO. S.S. 95-31 E 97.00

OCT 2 1 25 PM '84 40' BUFFER STRIP

DONNIE S. TANKERSLEY  
R.M.C.

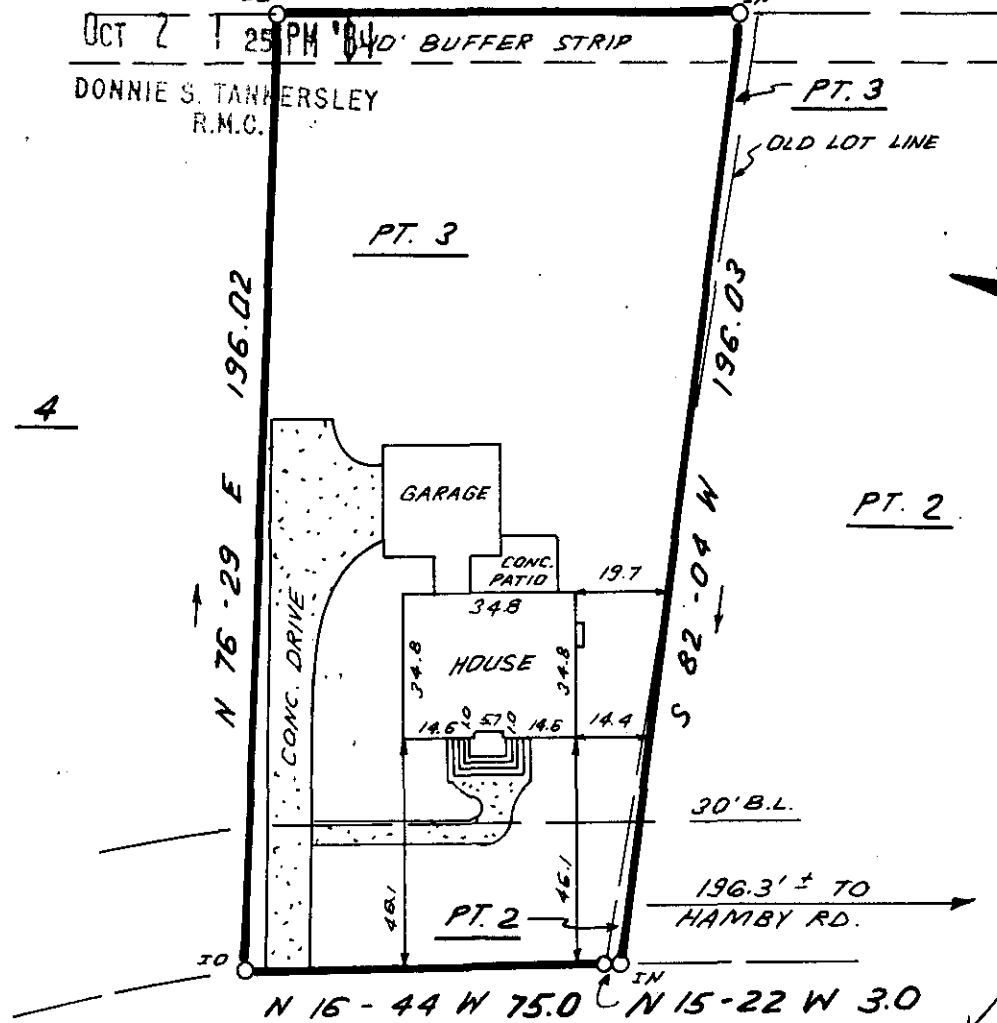


4

PT. 2

PT. 3

10184  
10-4-67

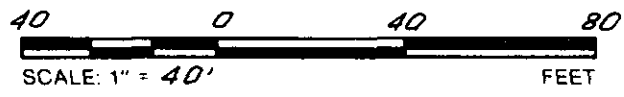


NOTE: 5' DRAINAGE & UTILITY EASEMENT  
ALONG EACH SIDE OF ALL SIDE &  
REAR LOT LINES.

THIS IS TO CERTIFY THAT THE PROPERTY SHOWN ON THIS PLAT WAS SURVEYED UNDER MY DIRECT SUPERVISION. PROPERTY LINES AND IMPROVEMENTS SHOWN ARE LOCATED CORRECTLY AND THAT NO VISIBLE ENCROACHMENTS EXIST UNLESS OTHERWISE SHOWN. THIS PROPERTY IS NOT LOCATED IN A DESIGNATED FLOOD HAZARD AREA.

STATE OF SOUTH CAROLINA  
GREENVILLE COUNTY

FREELAND & ASSOCIATES  
Engineers • Land Surveyors  
318 WEST STONE AVENUE.  
GREENVILLE, S.C.  
(803) 271-4924

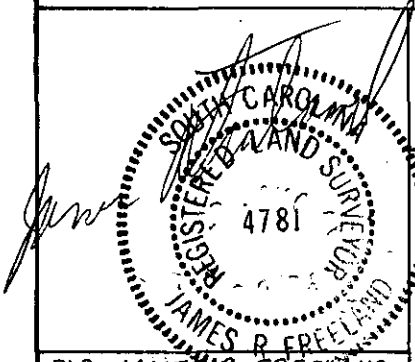

FORRESTER WOODS  
SEC. 6 ; PT. LOTS 2 & 3  
PROPERTY OF  
PHILLIP H. REEVES  
MARIA CLARA A. REEVES

PLAT BOOK	9W - 74
DEED BOOK	
TAX MAP	
PARTY CHIEF	W. B. H. III
DRAWN	I. R.
DATE	9-27-84
DWG. NO.	11831 OCT

RLS: JAMES R. FREELAND  
NO: 4781