



L.S. SPINKS

FILED
GREENVILLE CO. S.C.
Nov 2 9 54 AM '84
DONNIE S. HARRISLEY
R.M.C.

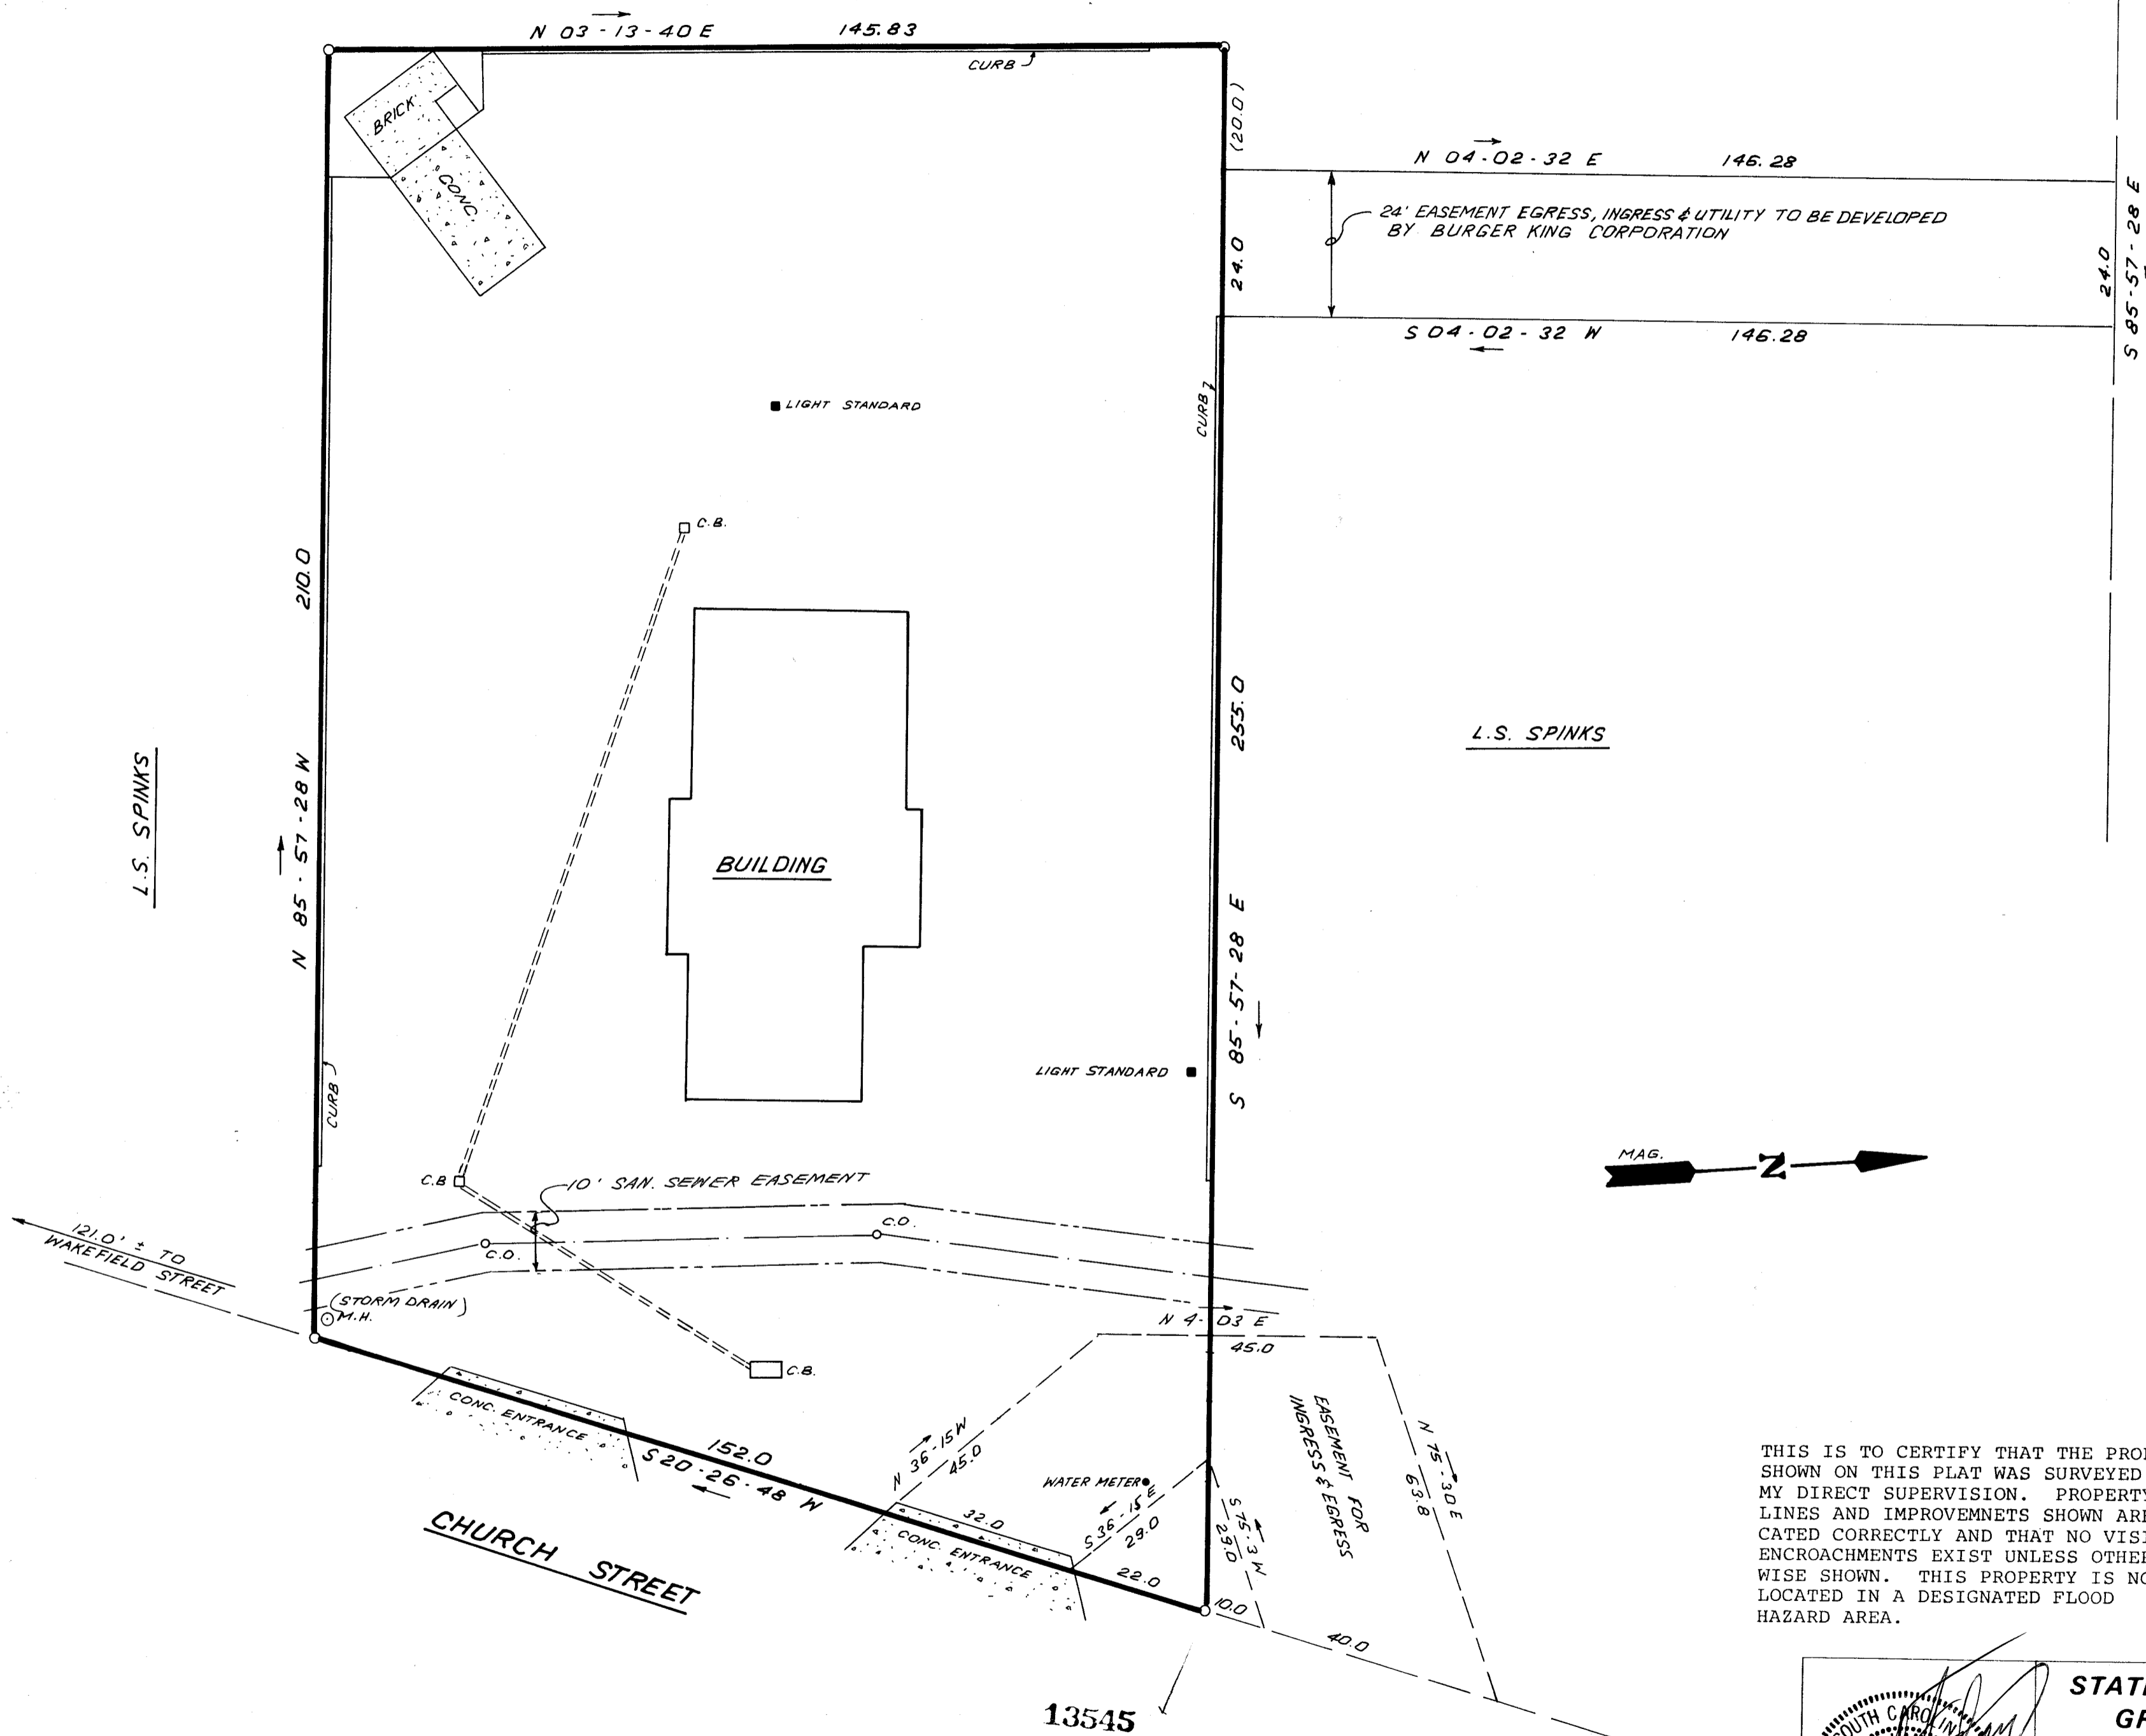


UNIVERSITY RIDGE

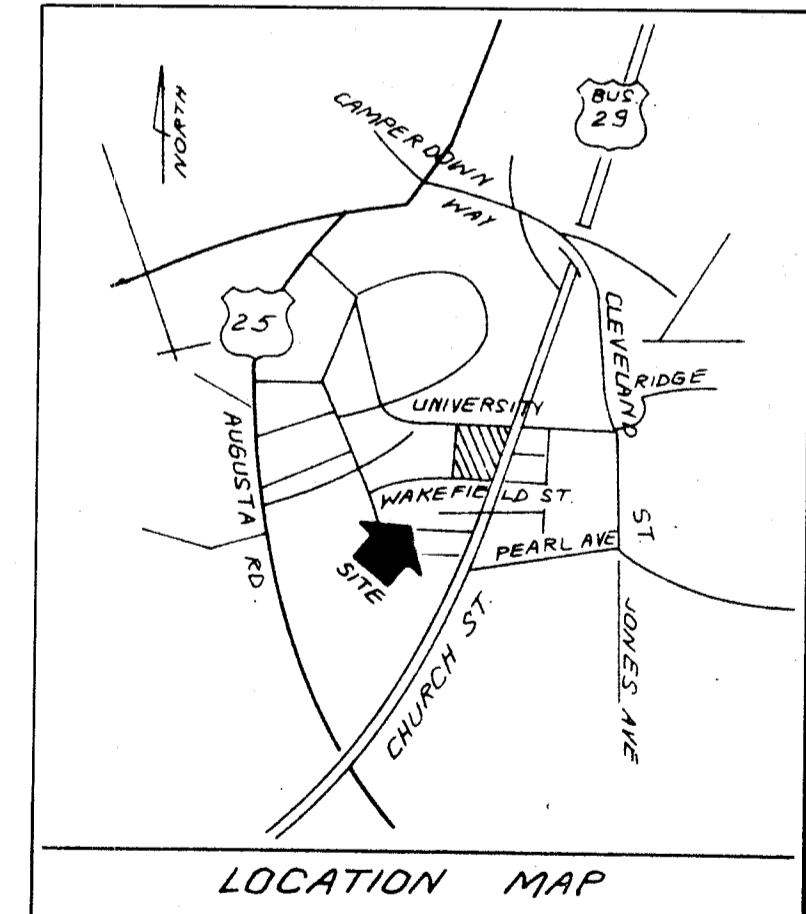

THIS IS TO CERTIFY THAT THE PROPERTY SHOWN ON THIS PLAT WAS SURVEYED UNDER MY DIRECT SUPERVISION. PROPERTY LINES AND IMPROVEMENTS SHOWN ARE LOCATED CORRECTLY AND THAT NO VISIBLE ENCROACHMENTS EXIST UNLESS OTHERWISE SHOWN. THIS PROPERTY IS NOT LOCATED IN A DESIGNATED FLOOD HAZARD AREA.

10-2-35

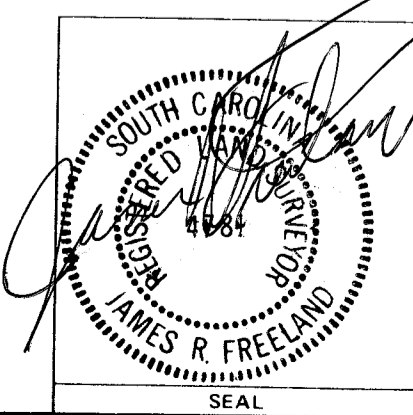

STATE OF SOUTH CAROLINA
GREENVILLE COUNTY

SURVEY FOR
LDS, INC.

FREELAND & ASSOCIATES
Engineers • Land Surveyors
GREENVILLE, S.C.

SURVEY	M.L.C.
DRAWN	I.R.
CHECK	M.C.C.
SCALE	1" = 20'
DATE	9-21-84
DWG. NO.	11794

MARSHALL

THE PRINT MACHINE, INC. N4337