

MICROFILMED

CERTIFIED TO:
Csaplak & Bok
Mortgage Lender (Bankers Life Company)
Lessee (Daniel International Corporation)
Owner (Daniel Properties 17)
Title Company (Lawyers Title Insurance Corporation)



This is to certify that this map or plat and the survey on which it is based were made in accordance with the "Minimum Standard Detail Requirements for Land Title Surveys" jointly established and adopted by ATA and ACSM in 1962.

I hereby certify that I have surveyed the property herein described, that this survey was made on the ground as per the record description, and that it is correct and is the true findings of a survey for loan purposes; further, that it shows the true location of improvements, and that there are no encroachments either way across property lines (except as noted, if any).

James R. Freeland

11-16-84
Dated

James R. Freeland
REGISTERED LAND SURVEYOR
AND CIVIL ENGINEER NO.: 4781
(S.C.)

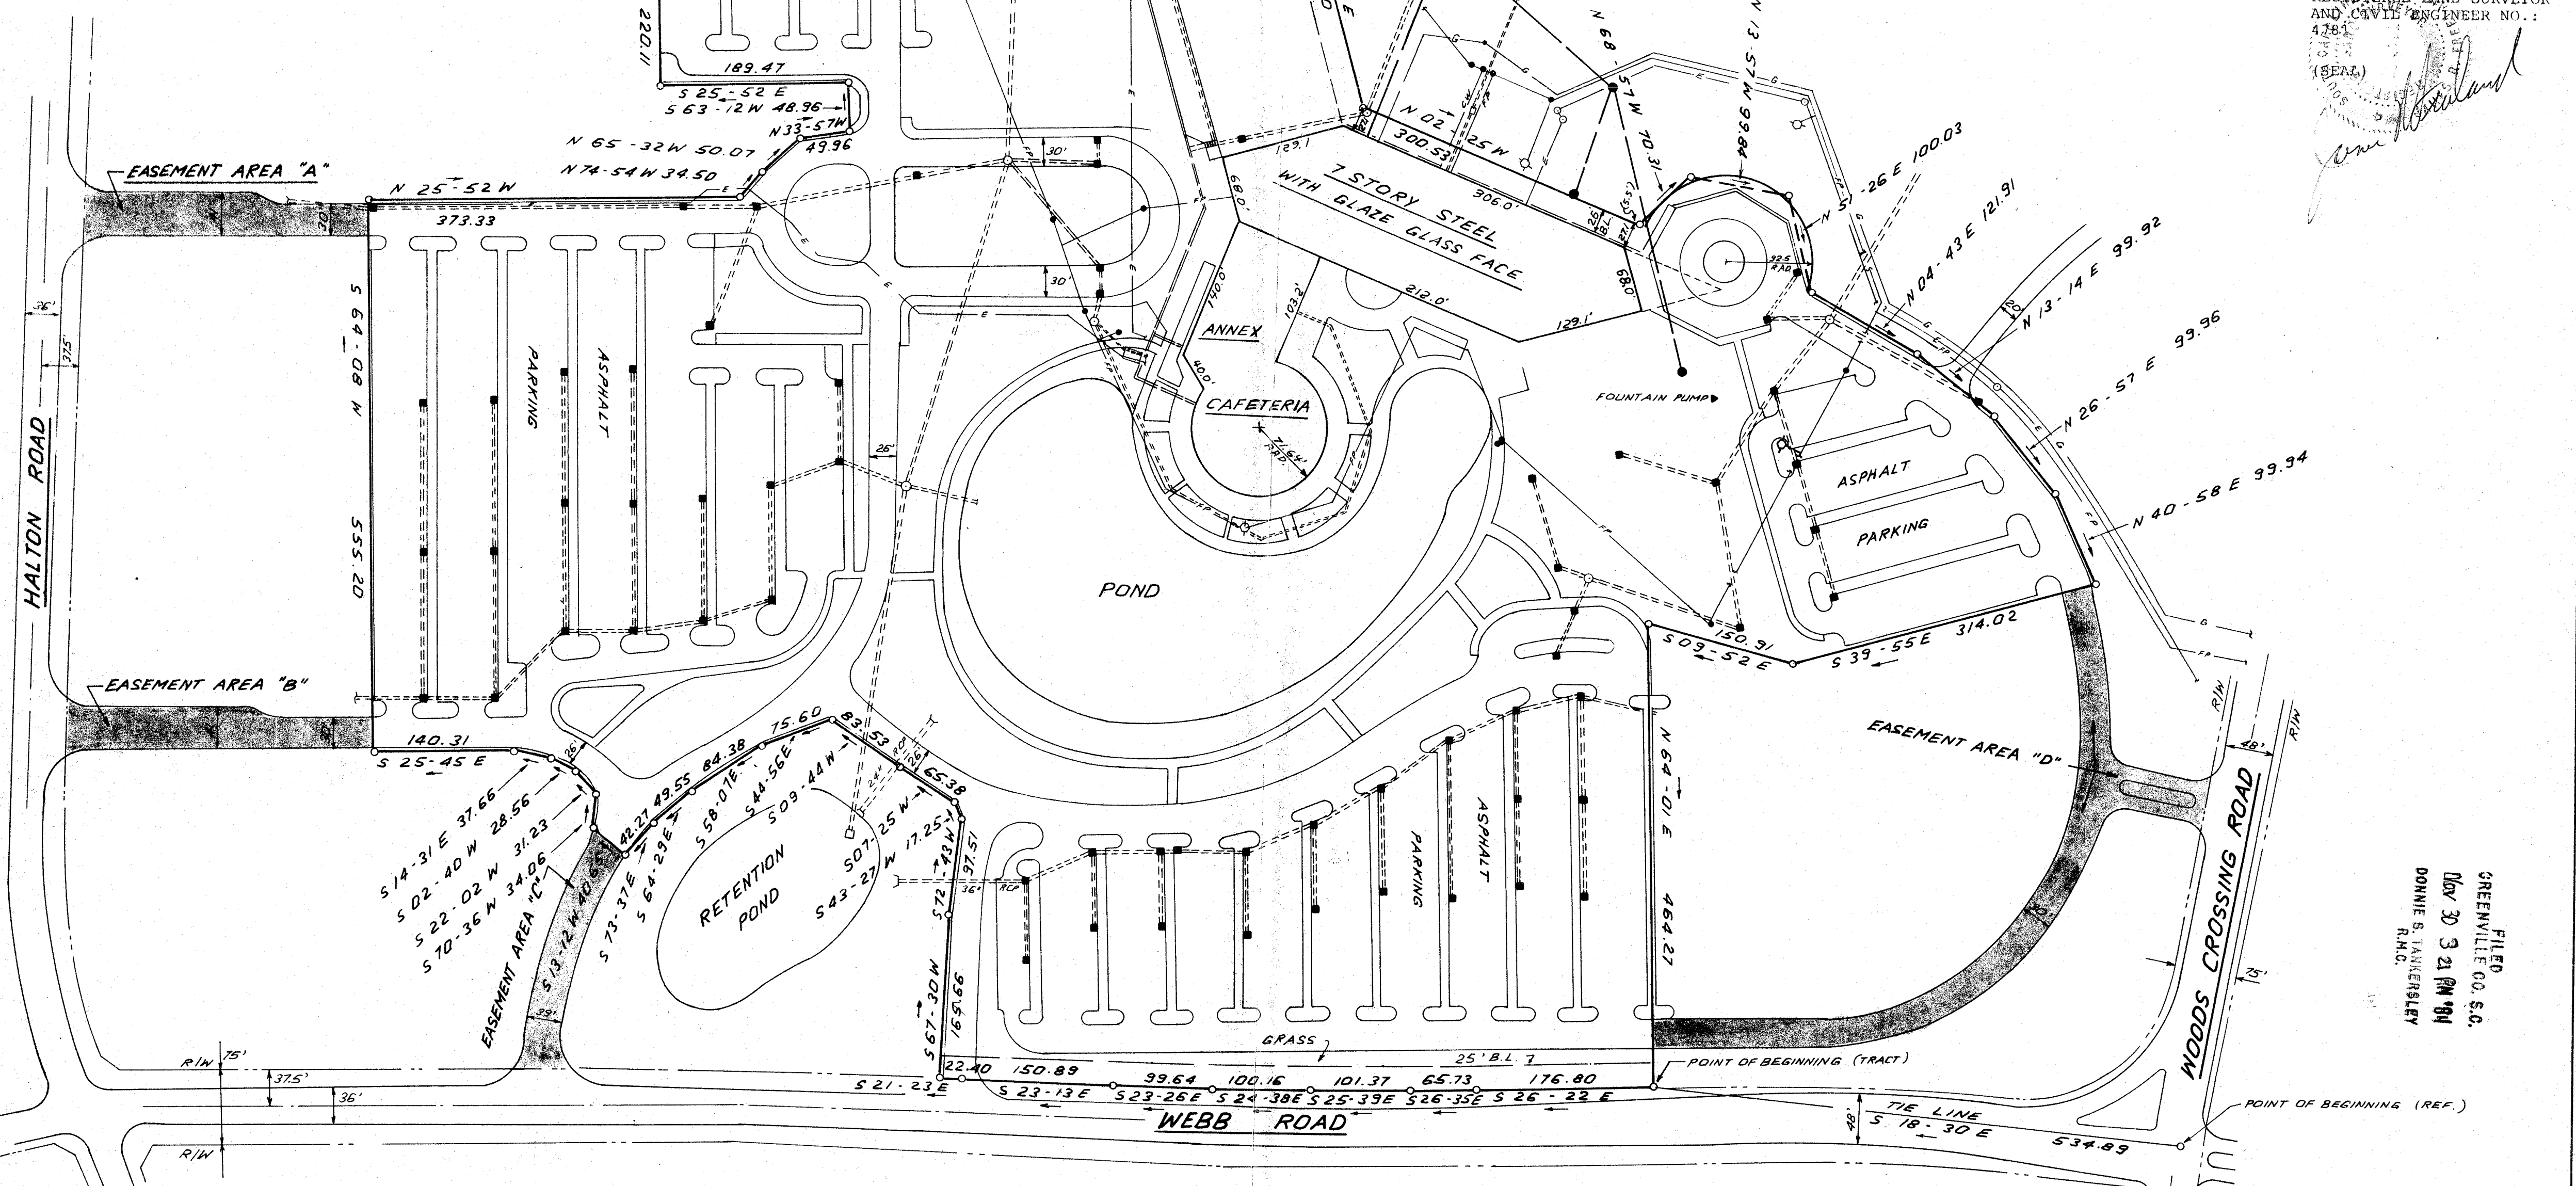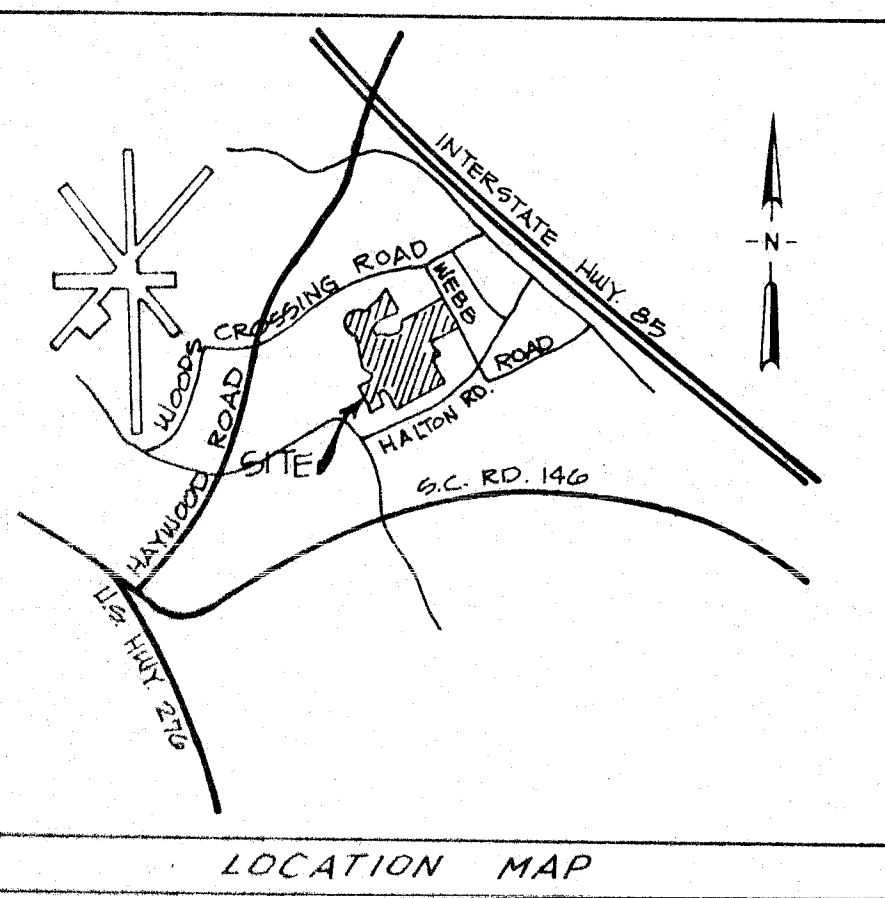

FILED
GREENVILLE CO. S.C.
Nov 30 3 21 PM 1984
DONNIE S. TANKERSLEY
R.M.C.

NOV 30 1984



10Z-68

I HEREBY CERTIFY THAT THE RATIO OF PRECISION OF THE FIELD SURVEY IS 1/5000 AS SHOWN HEREON AND THAT THE AREA WAS DETERMINED BY DMD METHOD

LEGEND	
■	CATCH BASIN
●	SAN SEWER MANHOLE
○	WATER METER/WATER VALVE
○	GAS METER
○	STORM MANHOLE
○	ELEC. MAN HOLE
○	FIRE HYDRANT
○	FOUNTAIN PUMP
---	STORM DRAIN
---	SAN. SEWER LINE

- NOTE:
- (1) Underground sprinkler system is not shown on plat.
 - (2) Parking lot lights, decorative lighting, and underground electric lines serving same are not shown on plat.
 - (3) IRON PINS AT ALL CORNERS
 - (4) THE CITY OF GREENVILLE ZONING REQUIRES A 25' FRONT BUILDING SET BACK LINE, 0' SIDE SET BACK LINE, AND A 26' REAR SET BACK LINE.

TOTAL ACRES 30.7538

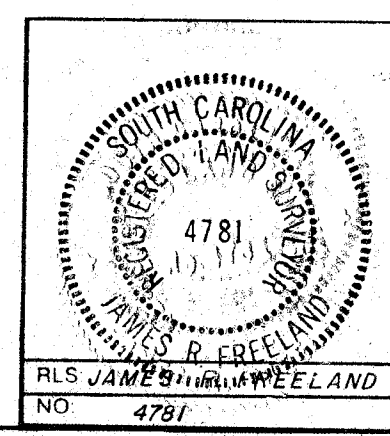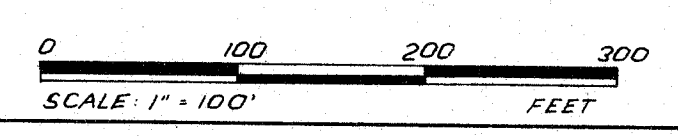

STATE OF SOUTH CAROLINA
GREENVILLE COUNTY

SURVEY FOR
DANIEL PROPERTIES 17

FREELAND & ASSOCIATES Engineers • Land Surveyors 316 WEST STONE AVENUE, GREENVILLE, S.C. (803) 271-4924	
PLAT BOOK	
DEED BOOK	
TAX MAP	
PARTY CHIEF	J.C.
DRAWN	I.R.
DATE	11 / 16 / 84
DWG NO	12 077