

FILED
GREENVILLE CO. S.C.

MAY 8 1 11 PM '85

DONNIE S. JANKERSLEY
R.N.C.

MINING
1962

COPE CIRCLE
WATER & SEWER IN ST 6" DIA

186-01 E
60.3

844.9

POINTSETT HIGHWAY


Note:
Improvements on this
lot are not in a flood
hazard area.

MAY 8 1985

188.9
565-104

EVA GOSWELL WATSON LIFE EST

PROPERTY OF
PAUL D. SLUSHER & SUSAN J. SLUSHER
NEAR GREENVILLE, S.C.
SCALE 1" = 40' 30 APR 1985

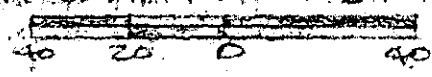

11-0-28

This is to certify that on the 30th day of April, 1985, I surveyed the property shown on this plat, being known as lot 9 on plat of COPE HEIGHTS and recorded in the RMC Office Greenville County, S. C., in Plat Book " III " at Page 103 and also known as PROPERTY OF PAUL D. SLUSHER & SUSAN J. SLUSHER and recorded in Plat Book at Page ; and that the property lines, walls and buildings are as shown hereon, and that the walls and buildings located on said lot do not encroach or project on adjacent street or property, and that no adjacent walls or buildings encroach or project on said premises, and no power lines cross this property except as shown hereon.

33851

R. B. Bruce

R. B. Bruce, RLS # 1952

CAROLINA SURVEYING CO.
112 Marly St., Greenville, S. C.

Recordable Plat