MICROFILMED

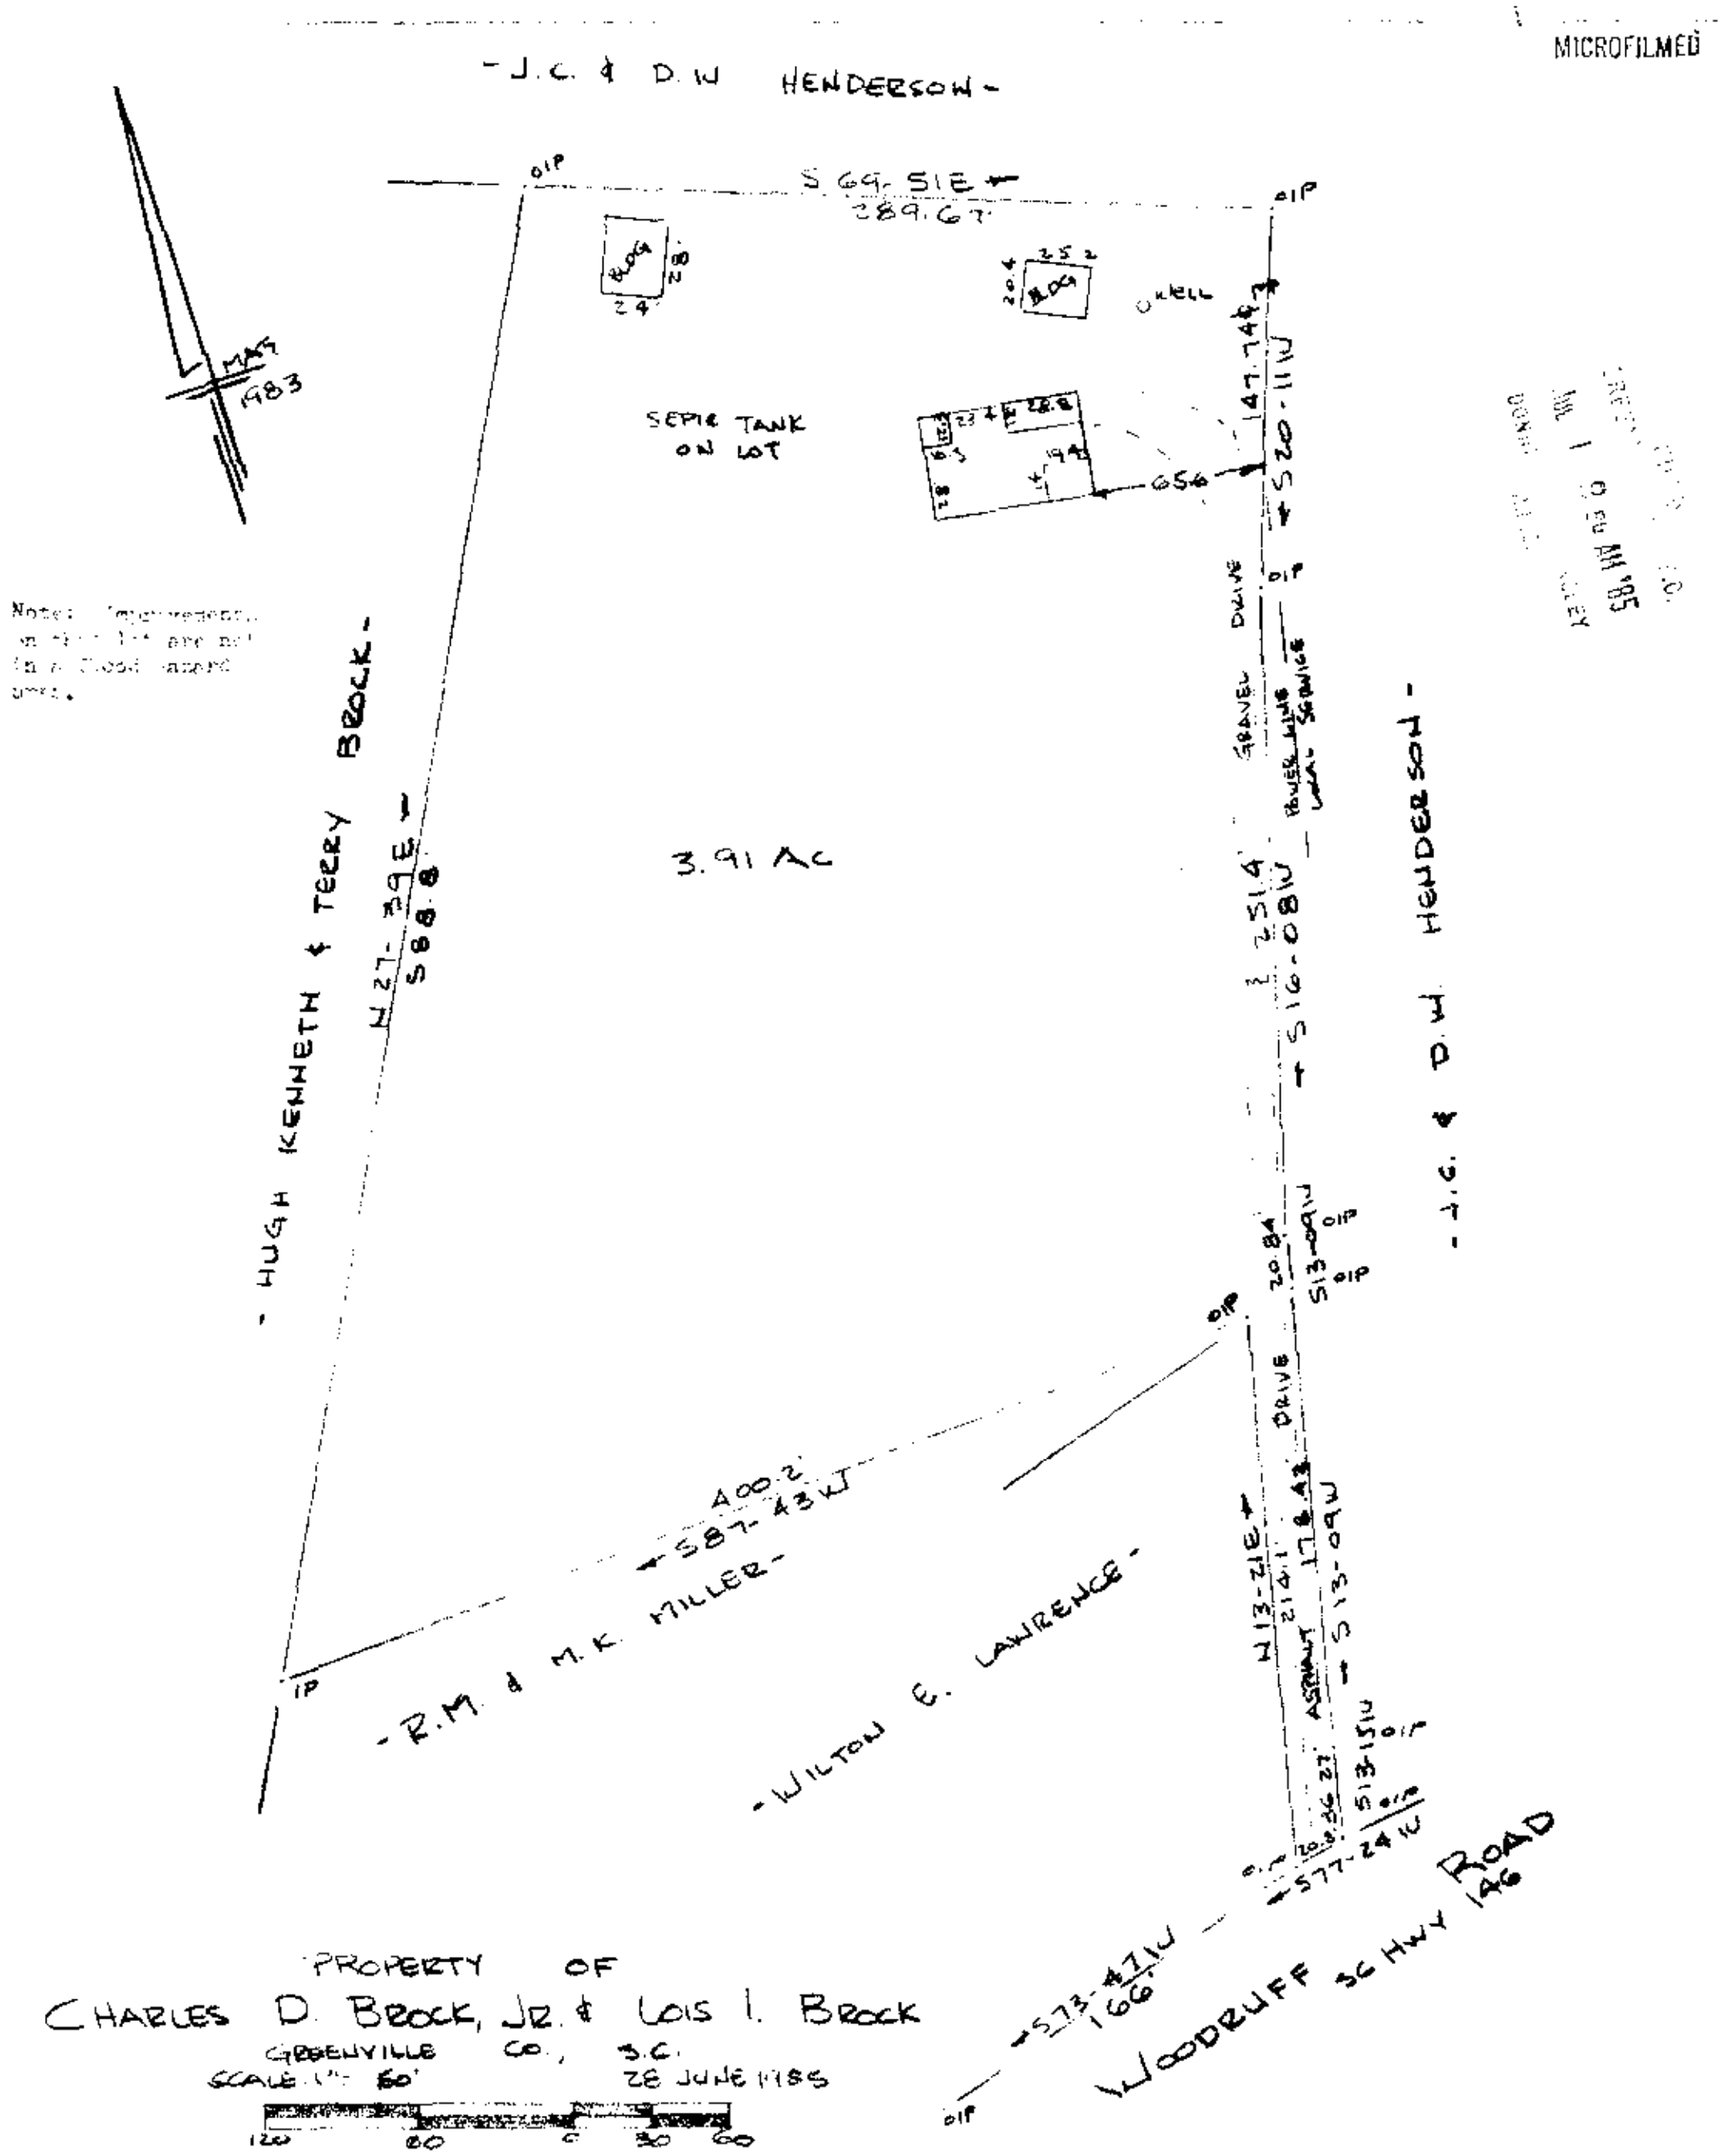

Notes: Improvements on this lot are not in a flood hazard area.

PROPERTY OF
CHARLES D. BROCK, JR. & LOIS I. BROCK
GREENVILLE CO., S.C.
SCALE 1" = 60' 28 JUNE 1985

This is to certify that on the 28th day of June, 1985, I surveyed the property shown on this plat, being known as 3.91 acres consisting of CHARLES D. BROCK, JR. & LOIS I. BROCK and recorded in the RMC Office, Greenville County, S. C., in Plat Book at Page ; and that the property lines, and the dimensions shown hereon, and that the size and buildings located on said lot do not encroach on, project on adjacent street or property, and that no adjacent walls or buildings encroach or project on said premises, and no power lines cross this property except as shown hereon.

JUL 1 1985

11P-49

244

CAROLINA SURVEYING CO.
132 Manly St.
Greenville, S. C.

R. S. Bruce, S. C. RLS 10286

Recordable Plat