MICROFILMED

Note:

This Is Lot # 23 And Part Of Lot # 24, 25 & 26 Section B Roosevelt Heights. Plat Book W - Page 129. This Is Also Part Of Lot # 22.

Part Of Lots # 22,24, And 25 To Be Combined With # 23.

FILED
GREENVILLE CO., S.C.
Nov 27 1 58 PM '85
DONNIE S. TANKERSLEY
R.M.C.

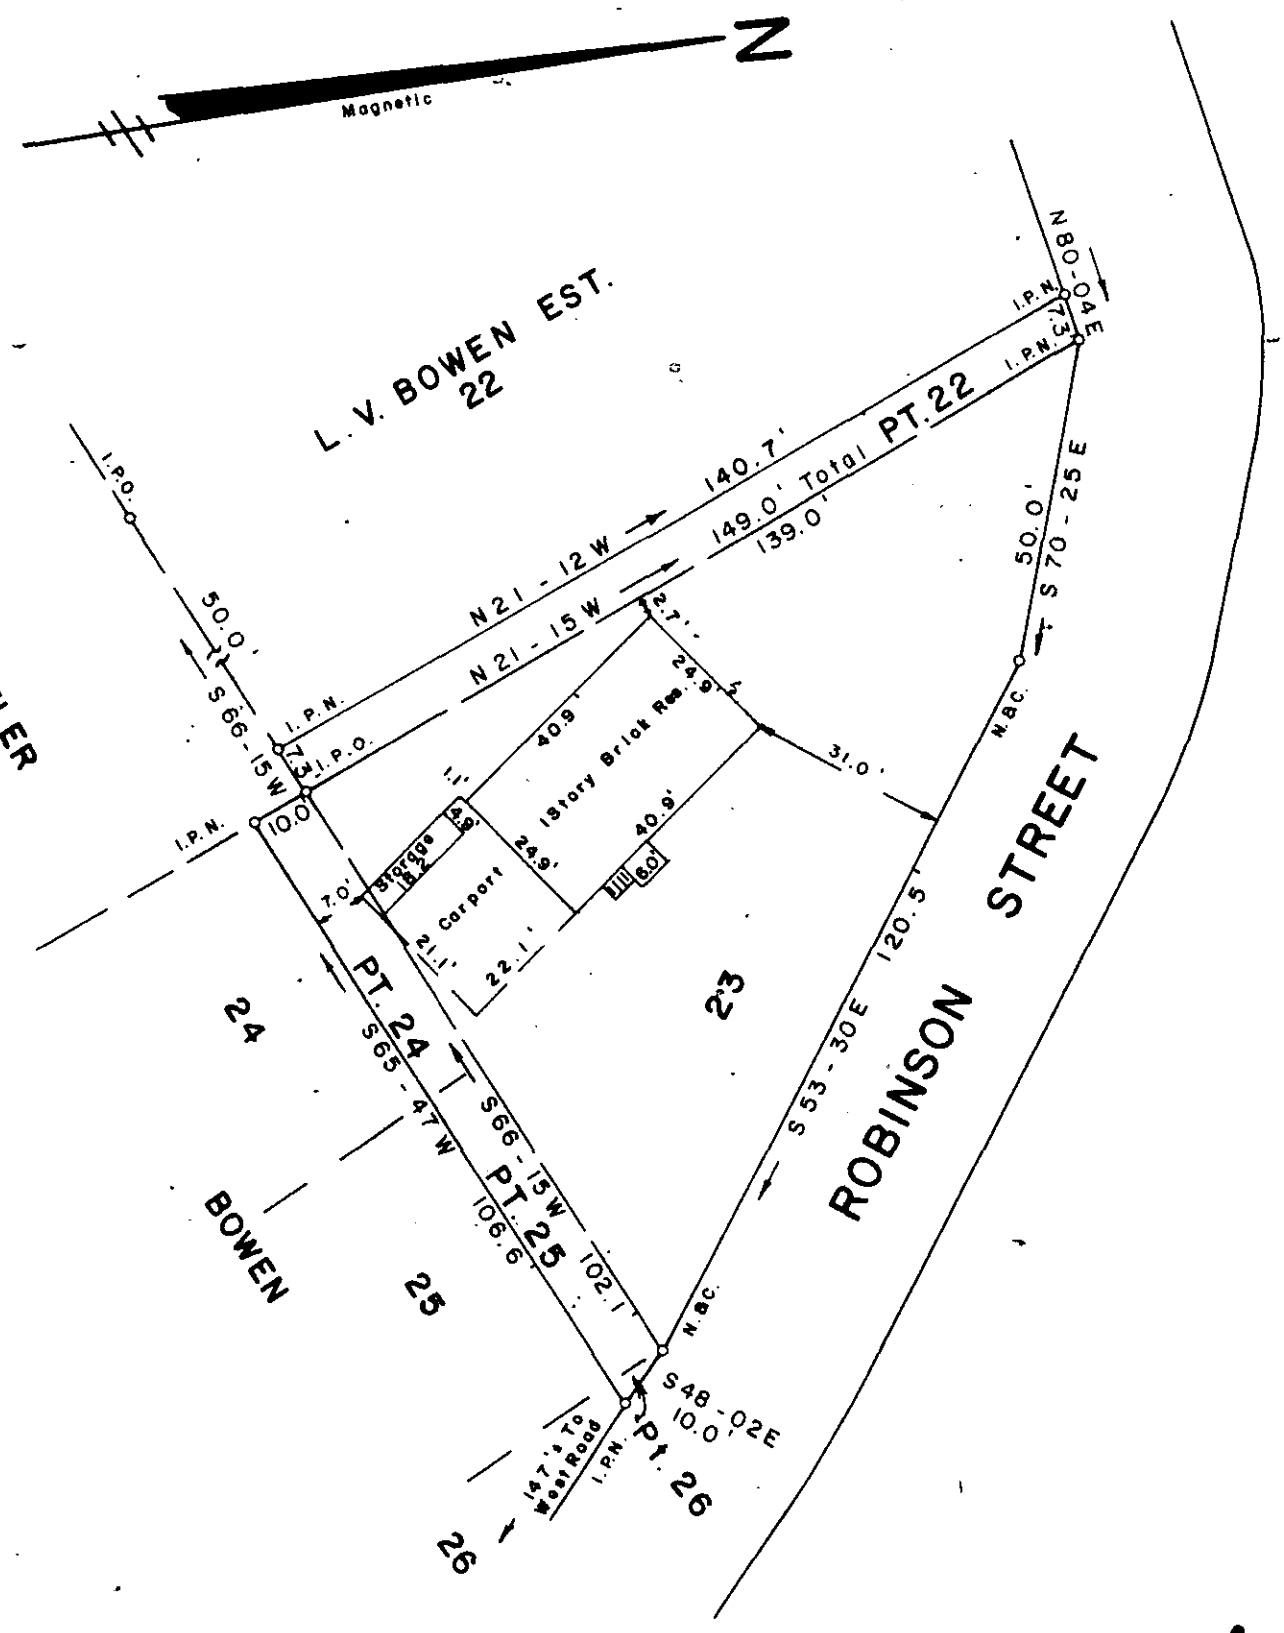

12-E-17

SURVEY FOR

CHARLES EDWARD ROBERTSON
SANDRA W. ROBERTSON

18257

CITY OF TRAVELERS REST GREENVILLE COUNTY

SOUTH CAROLINA

NOVEMBER 20, 1985

NOV 27 1985

To The Best Of My Knowledge This Structure Is Not In An Established Flood Zone

I Hereby Certify That The Measurements As Shown Above Are Correct And There Are No Encroachments Or Projections Other Than Shown

I Hereby Certify That The Ratio Of Precision Of The Field Survey Is 1/5000 As Shown Hereon And The Area Was Determined By Computer.

R.L.S. # 7881

Scale 1" = 30'

JEFFERY M. PLUMBLEE, INC.
LAND SURVEYING

P. O. BOX 788
TRAVELERS REST, S. C. 29690
(803) 834-4426

506.4-6-26

F.B. 22

5.00 8 11801