


Note: Improvements on this lot are not in a flood hazard area.

Note: There is a drainage & utilities easement 5' each side of all side and rear lot lines.

FILED
GREENVILLE CO. S. C.
JAN 2 10 00 AM '86
DONNIE S. JANKERS
R.M.C.

PROPERTY OF
RONALD H. BROWN & SAUL H. BROWN
NEAR GREENVILLE, S.C.
SCALE: 1" = 40' 30 DEC 1985

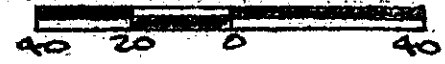

JAN 2 1986

This is to certify that on the 30th day of December, 1985, I surveyed the property shown on this plat, being known as lot 11 on plat of TAYLOR HEIGHTS and recorded in the REC Office Greenville County, S. C., in Plat Book " 4 - X " at Page 2; and that the property lines, walls and buildings are as shown hereon, and that the walls and buildings located on said lot do not encroach or project on adjacent street or property, and that no adjacent walls or buildings encroach or project on said premises, and no power lines cross this property except as shown hereon.

12-G-50 24026

CAROLINA SURVEYING CO.
112 Farley St.
Greenville, S. C.

R. B. Bruce
R. B. Bruce, RLS # 1952