


WELLS B. MCDANIEL ET AL

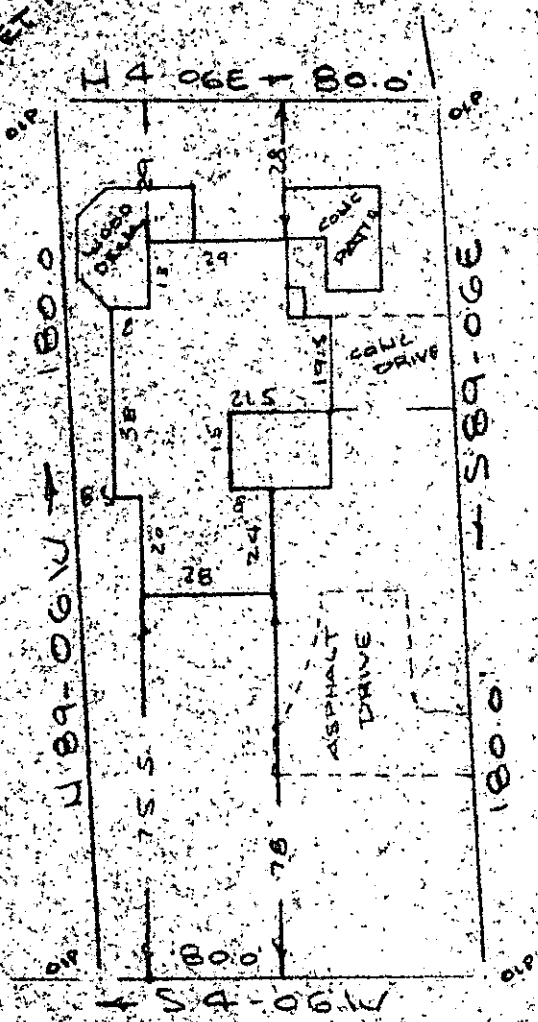

Note: Improvements on this lot are not in a flood hazard area.

FILED  
GREENVILLE CO. S.C.  
JUN 23 11 58 AM '86  
DONNIE S. JANKERSLEY  
R.M.C.

MCDANIEL AVENUE  
WATER & SEWER IN ST R/W

PROPERTY OF  
JAMES D. CALMES III & JUDY B. CALMES  
GREENVILLE, S.C.  
SCALE 1" = 40' 29 MAY 1986

This is to certify that on the 29th day of May, 1986, I surveyed the property shown on this plat, being known as PROPERTY OF JAMES D. CALMES III & JUDY B. CALMES and recorded in the RMC Office Greenville County, S.C., in Plat Book at Page [ ] and that the property lines, walls and buildings are as shown hereon, and that the walls and buildings located on said lot do not encroach or project on adjacent street or property, and that no adjacent walls or buildings encroach or project on said premises, and no power lines cross this property except as shown hereon.

43163

12-W-34

JUN 23 1986

R. B. Bruce

R. B. Bruce, RLS #1952

R. B. Bruce

CAROLINA SURVEYING CO.  
112 Morris St. 56  
Greenville, S.C.

Recordable Plat