MICROFILMED

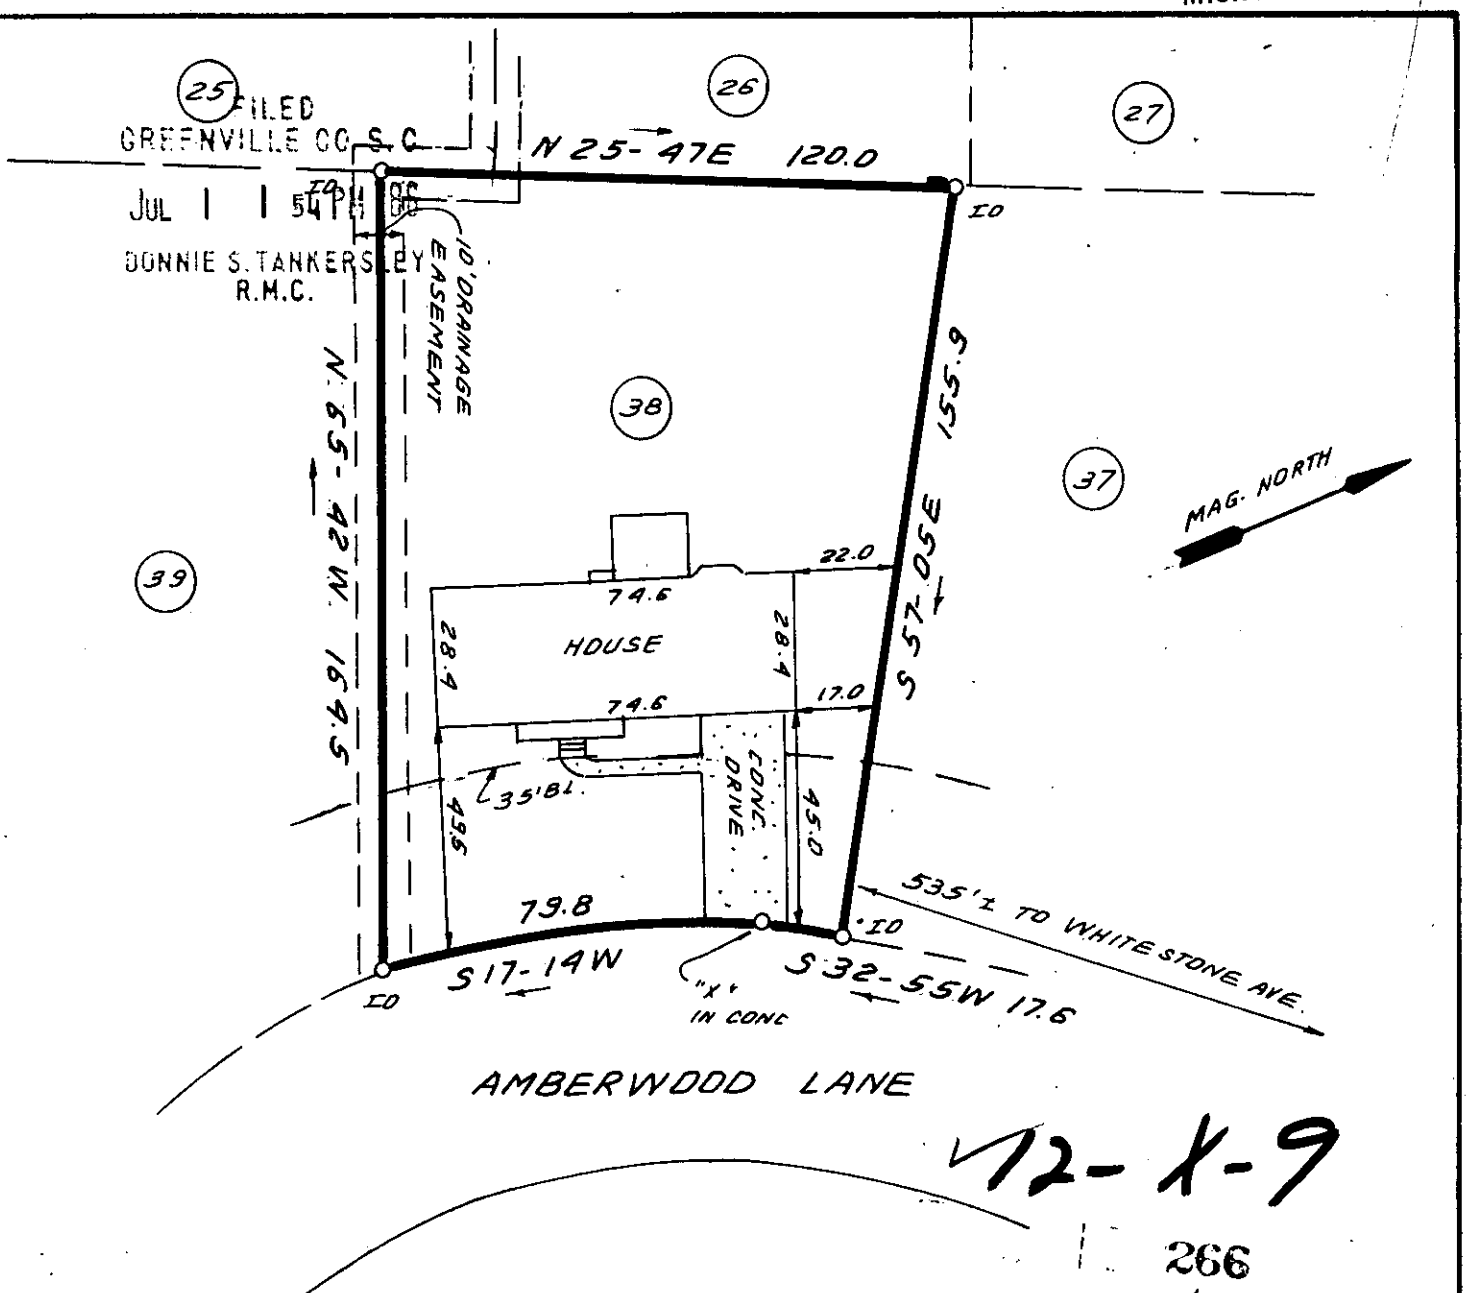

72-X-9

266

NOTE: 5' DRAINAGE & UTILITY EASEMENT ALONG EACH SIDE OF ALL SIDE AND REAR LOT LINES

0 40 80 120

SCALE: 1" = 40 FEET

THIS IS TO CERTIFY THAT THE PROPERTY SHOWN ON THIS PLAT WAS SURVEYED UNDER MY DIRECT SUPERVISION. PROPERTY LINES AND IMPROVEMENTS SHOWN ARE LOCATED CORRECTLY AND THAT NO VISIBLE ENCROACHMENTS EXIST UNLESS OTHERWISE SHOWN. THIS *PROPERTY* IS *NOT* LOCATED IN A DESIGNATED FLOOD HAZARD AREA.

SOUTH CAROLINA REGISTERED LAND SURVEYOR 4781 JAMES R. FREELAND

RLS: JAMES R. FREELAND
NO: 4781

STATE OF SOUTH CAROLINA
GREENVILLE COUNTY

ADAMS MILL ESTATES
LOT 38
PROPERTY OF
CHARLES F. MILLER
ANGELA RICHARDSON

FREELAND-CLINKSCALES & ASSOCIATES, INC.
Engineers • Land Surveyors
323 WEST STONE AVENUE
GREENVILLE, S.C.
(803) 271-4924

PLAT BOOK	4R-31
DEED BOOK	1258-382
TAX MAP	M.7.5-1-38
PARTY CHIEF	JCC
DRAWN	BR
DATE	7-1-86
DWG. NO.	15670

THE PRINT MACHINE, INC. N73428