


FILED
GREENVILLE CO., S. C.

JUN 9 9 41 AM 1951

OLLIE PARSONS WORTH
R. D. 6.

13499

JUN 9 1951

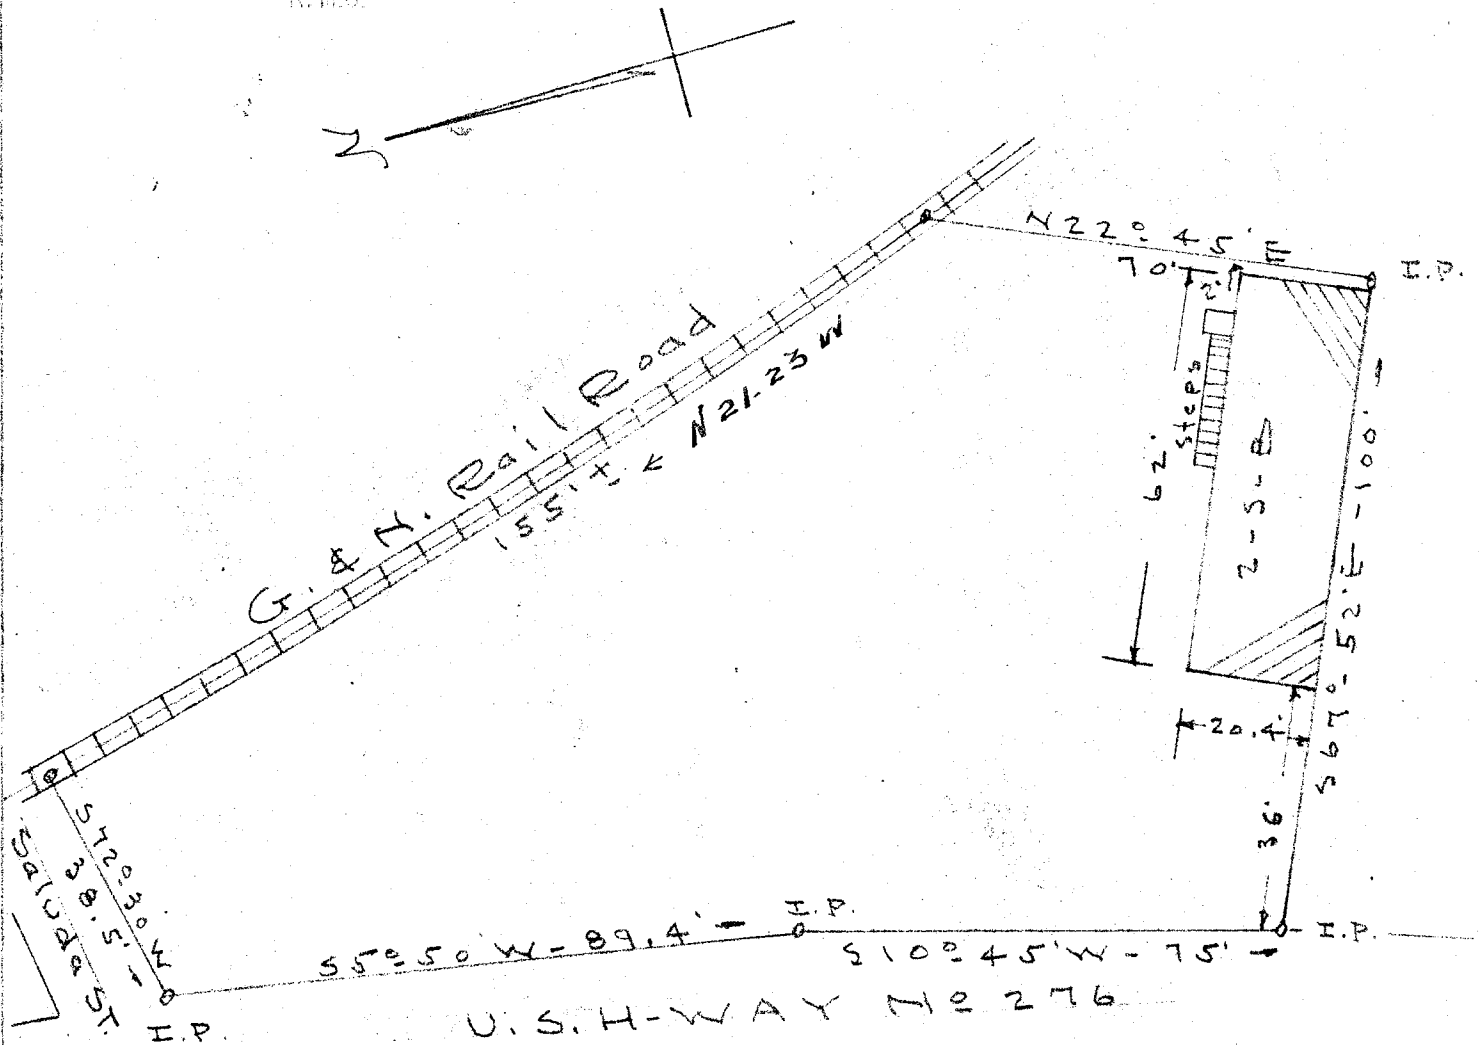

PROPERTY OF
J. NORWOOD CLEVELAND
Marietta, S. C.
Scale 1" = 30' - June-5-51

This is to certify that on the 4th. day of June, 1951. I surveyed the property shown on this plat, being known as part of Tract No. 1- Cleveland Property, located at Marietta, S. C., and that the property lines, walls and buildings are as shown hereon; that the buildings located on said lot do not encroach or project on adjacent streets or property, and that no adjacent buildings, or walls, encroach or project on said premises.

J. C. Neal
Registered Land Surveyor.

#13499 Filed This 9 day of June 1951
And Recorded in Vol. 117 Page 55 at M.
Ollie Parsons Worth
Register Means Conveyance Greenville County, S. C.