
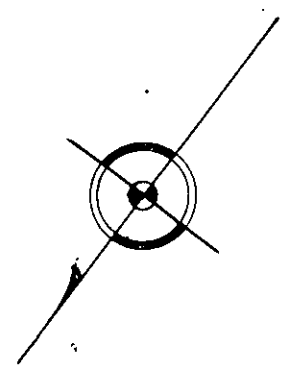


See Deed to this Plat See Deed Book 450 Page 105

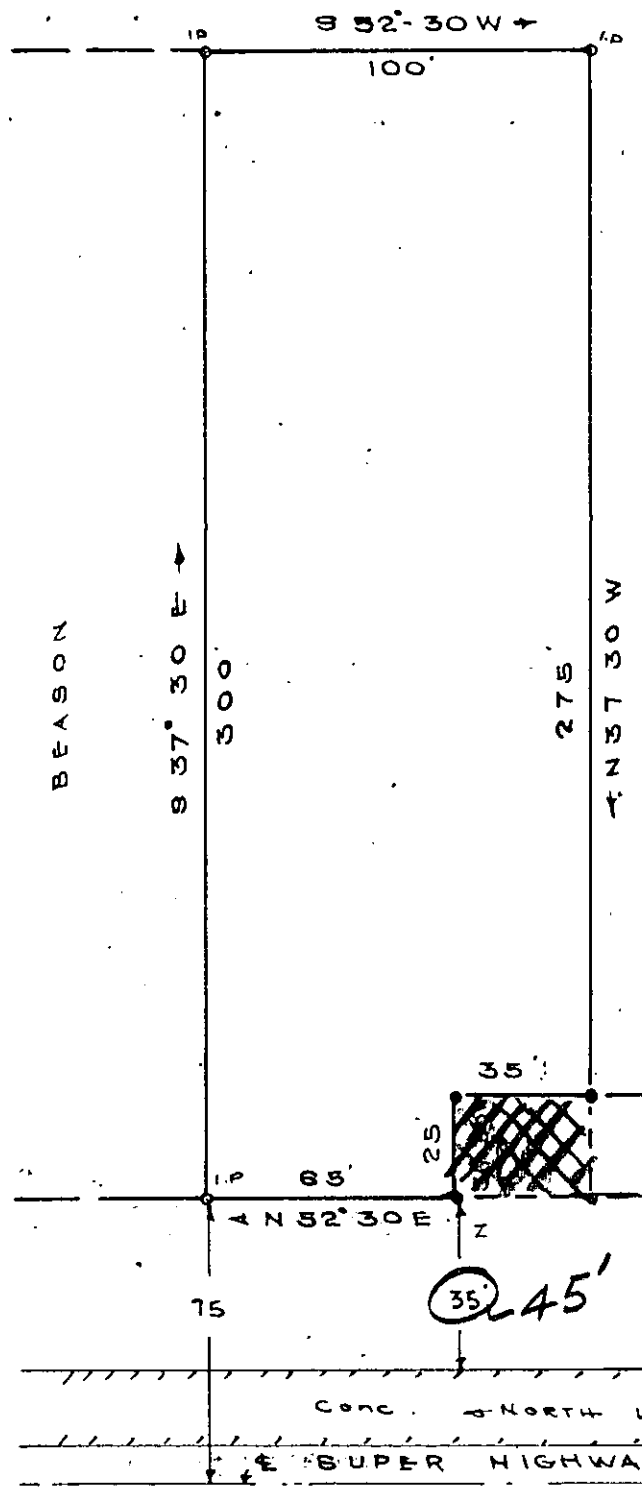

Note: This is a portion of track recorded in Plat Book 'U' # 125 RMC. Office.

Property of  
J. T. MELTON COMPANY, INC.  
GREENVILLE, S.C.

Scale 1" = 50' Oct 27 1951



Recorded January 28th, 1952 at  
 9:50 A. M. #2144

By C. C. JONES Reg. Eng.