

Greenville  
 RD. 3. 661R  
 Correll  
 E. C. 74

Toll Line } Cassays Head Loop  
 (Name)

Or Exchange Line }  
 tributary to (Exchange)

The Property is bounded where the line enters and leaves this property by the property of:

Mays Island on the N and  
Marietta Baltis Creek on the S


Number of poles covered by this permit: \_\_\_\_\_

Number of Guys and Anchors: 1

The poles have the following numbers: 122

from No. \_\_\_\_\_ to No. \_\_\_\_\_

Poles are located on private property and in Streets and Highways as shown on the following diagram.

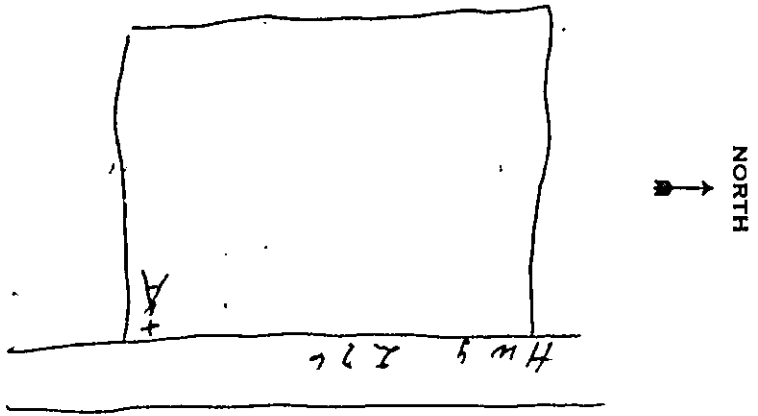

Form 6196-A (Sept., '40)

GENERAL PERMIT

\$ 1.00 Received of the SOUTHERN BELL TELEPHONE AND TELEGRAPH COMPANY, (INCORPORATED)


One & no /100 Dollars in consideration of which I hereby grant unto said Company, its associated and allied companies, their respective successors and assigns, the right, privilege and authority to construct, operate and maintain its lines of Telephone and Telegraph, and for the general transmission of intelligence, consisting of such poles, wires, cables, conduits, guys, anchors and other fixtures and appurtenances as the grantee may from time to time require, upon, across, over and/or under the property which I own or in which I have any interest in the County of Greenville and State of SC and upon, along and/or under the roads, streets, or highways adjoining the said property, and the right to permit the attachment of and/or carry in conduit wires and cables of any other company or person, and with the further right to trim and cut down and to keep trimmed and cut down all trees and undergrowth within 12 feet of said line, and in addition thereto, the grantee shall have the right to cut down, from time to time, all dead, weak, leaning or dangerous trees that are tall enough to reach the wires in falling; said sum being received in full payment for the rights herein granted.

Witness my hand and seal this 22 day of Feb 19 52, at Marietta SC (Post Office Address)  
 Witness B. Lester Huff James N. Cleveland II (L.S.)  
C. J. Hofford (Land Owner) (L.S.)

STATE OF SOUTH CAROLINA,  
 COUNTY OF GREENVILLE

Personally appeared before me C. J. Hofford and James N. Cleveland II made oath that he owned the above property and as his legal agent, and that he with B. Lester Huff witnessed the execution thereof.

Subscribed before me, this 25th day of February A.D., 1952

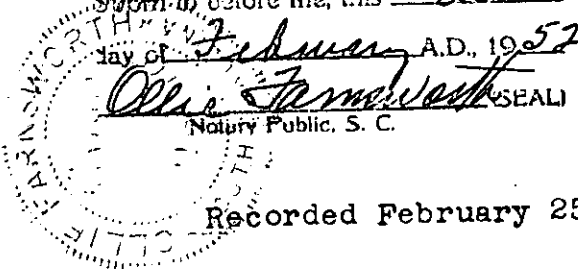

Recorded February 25th. 1952 at 2:25 P. M. #4606