

GREENVILLE, S.C. *Consul*
 EST. S-R 768 *W. A. Hancock*
 CODE 97E *Boy. Suppl.*

Toll Line } GREENVILLE - EASLEY
 (Name)

Or Exchange Line } _____
 tributary to _____ (Exchange)

The Property is bounded where the line enters and leaves this property by the property of:

WALLACE CORBELL on the E and

BOONE ALEXANDER on the W


Number of poles covered by this permit: _____

Number of Guys and Anchors: 1

The poles have the following numbers:

PT. No. 69 to No. _____

Poles are located on private property and in Streets and Highways as shown on the following diagram.

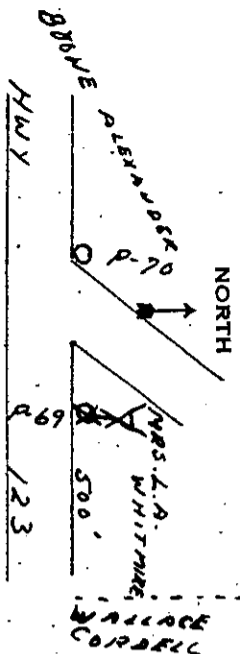

Form 6196-A (Sept., '40)

GENERAL PERMIT

Received of the SOUTHERN BELL TELEPHONE AND TELEGRAPH COMPANY, (INCORPORATED)

One + no /100 Dollars in consideration of which I hereby grant unto said Company, its associated and allied companies, their respective successors and assigns, the right, privilege and authority to construct, operate and maintain its lines of Telephone and Telegraph, and for the general transmission of intelligence, consisting of such poles, wires, cables, conduits, guys, anchors and other fixtures and appurtenances as the grantee may from time to time require, upon, across, over and/or under the property which I own or in which I have any interest in the County of GREENVILLE and State of S.C. and upon, along and/or under the roads, streets, or highways adjoining the said property, and the right to permit the attachment of and/or carry in conduit wires and cables of any other company or person, and with the further right to trim and cut down and to keep trimmed and cut down all trees and undergrowth within 15 feet of said line, and in addition thereto, the grantee shall have the right to cut down, from time to time, all dead, weak, leaning or dangerous trees that are tall enough to reach the wires in falling; said sum being received in full payment for the rights herein granted.

Located along Highway 123.

Witness My hand and seal this 6 day of JUNE 19 52 at 4 Nona St. GREENVILLE, S.C. (Post Office Address)

Witness Emma Caehart Mo. Leonard A. Whitmire (L. S.)
W. A. Hancock (Land Owner) (L. S.)
MRS. LEONARD A. WHITMIRE

JUL 14 1952.

STATE OF SOUTH CAROLINA
 COUNTY OF GREENVILLE

Personally appeared before me W. A. Hancock and made oath that he saw the within named Mrs. Leonard A. Whitmire sign, seal and as his her their not and deed, deliver the within instrument, and that he with Emma Caehart witnessed the execution thereof.

Sworn to before me, this 14th day of July A.D. 1952 W. A. Hancock

Bernie Ward Sinclair
 Notary Public, S. C.

Recorded July 14th. 1952 at 10:42 A. M. #15530