


MATERIAL

- 1 - 16" x 8" Tap Sleeve
- 1 - 8" Tap Valve
- 1 - Valve Box
- 31' of 8" Pipe
- 1 - 8" Plug Tap 2"
- Killed 710' ± of 2" Galv. on Henderson Dr.
- Killed 500' ± of 2" Galv. on Carter Dr.

RETAIN

- 1 - 16" x 8" Tap Sleeve
- 1 - 8" Tap Valve
- 31' of 8" Pipe
- 1 - 8" Plug Tap 2"
- Labor & Equipment by G.W.W.
- 1190' of 2" Galv. Water Main on Fairlane Circle

N

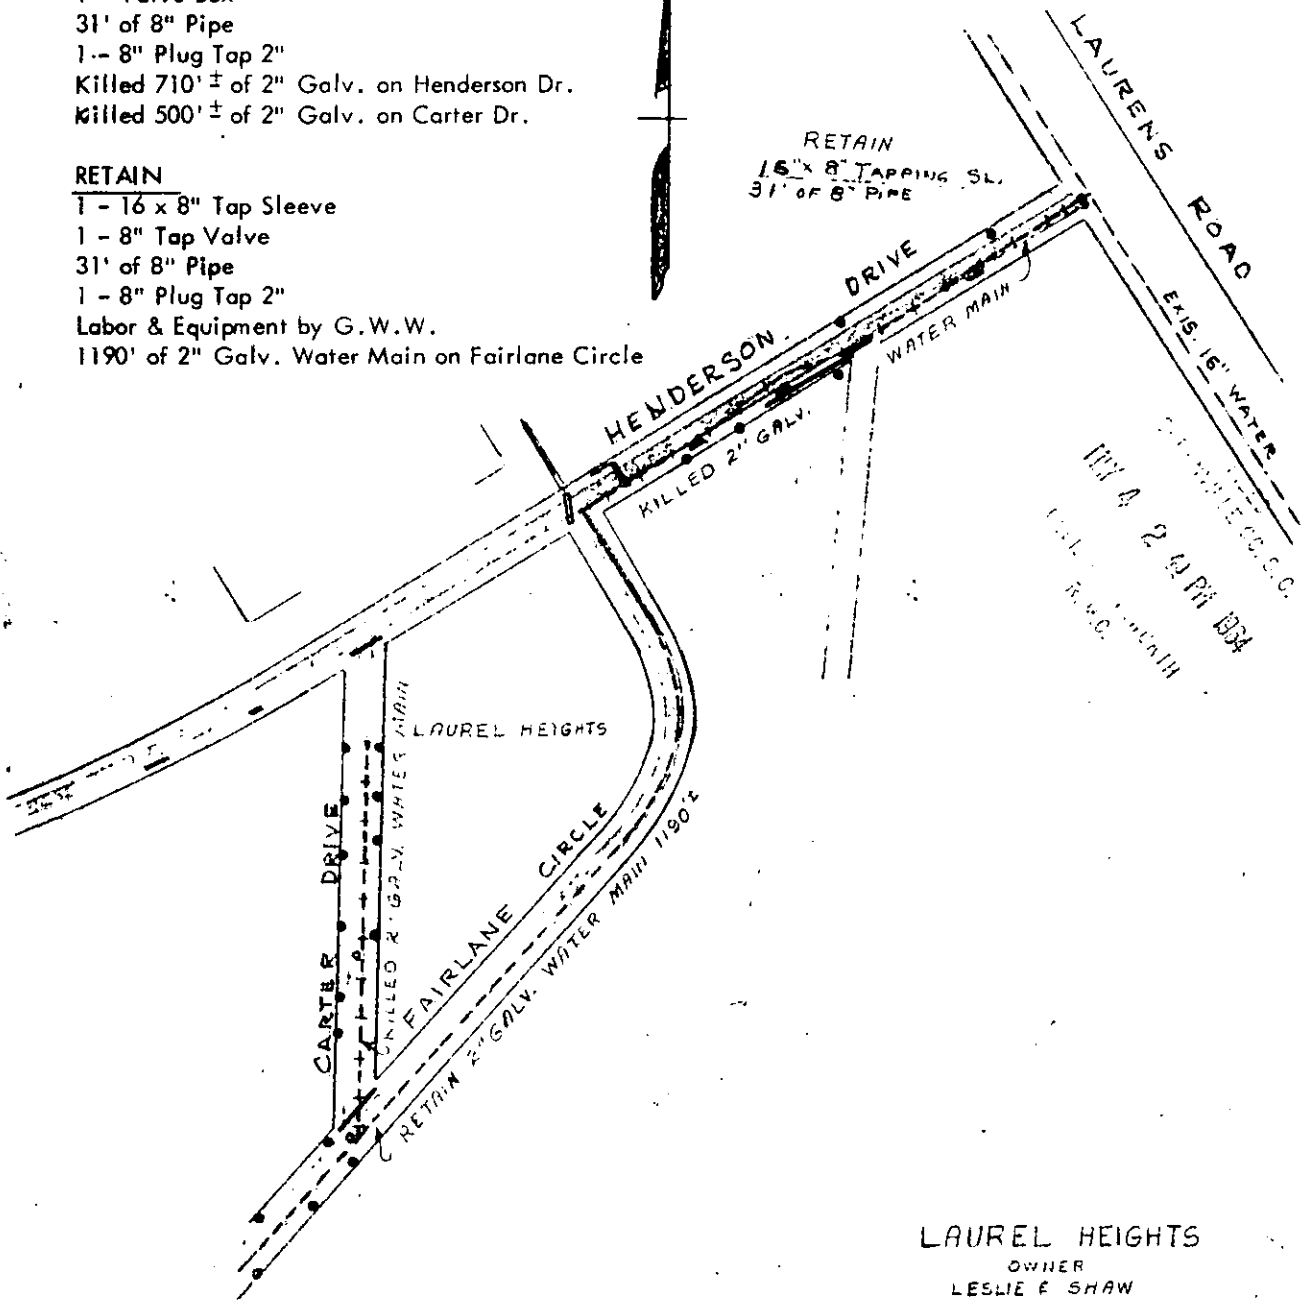

LAUREL HEIGHTS
 OWNER
 LESLIE F. SHAW
 TO GREENVILLE WATER WORKS

SCALE
 1" = 200'

Recorded May 4, 1964 At 2:48 P.M. # 31097