


2" GALV.	805 ±
2 1/2" GALV.	2800 ±
3" GALV.	2400 ±
6" C.I.	3485 ±
8" C.I.	33 ±

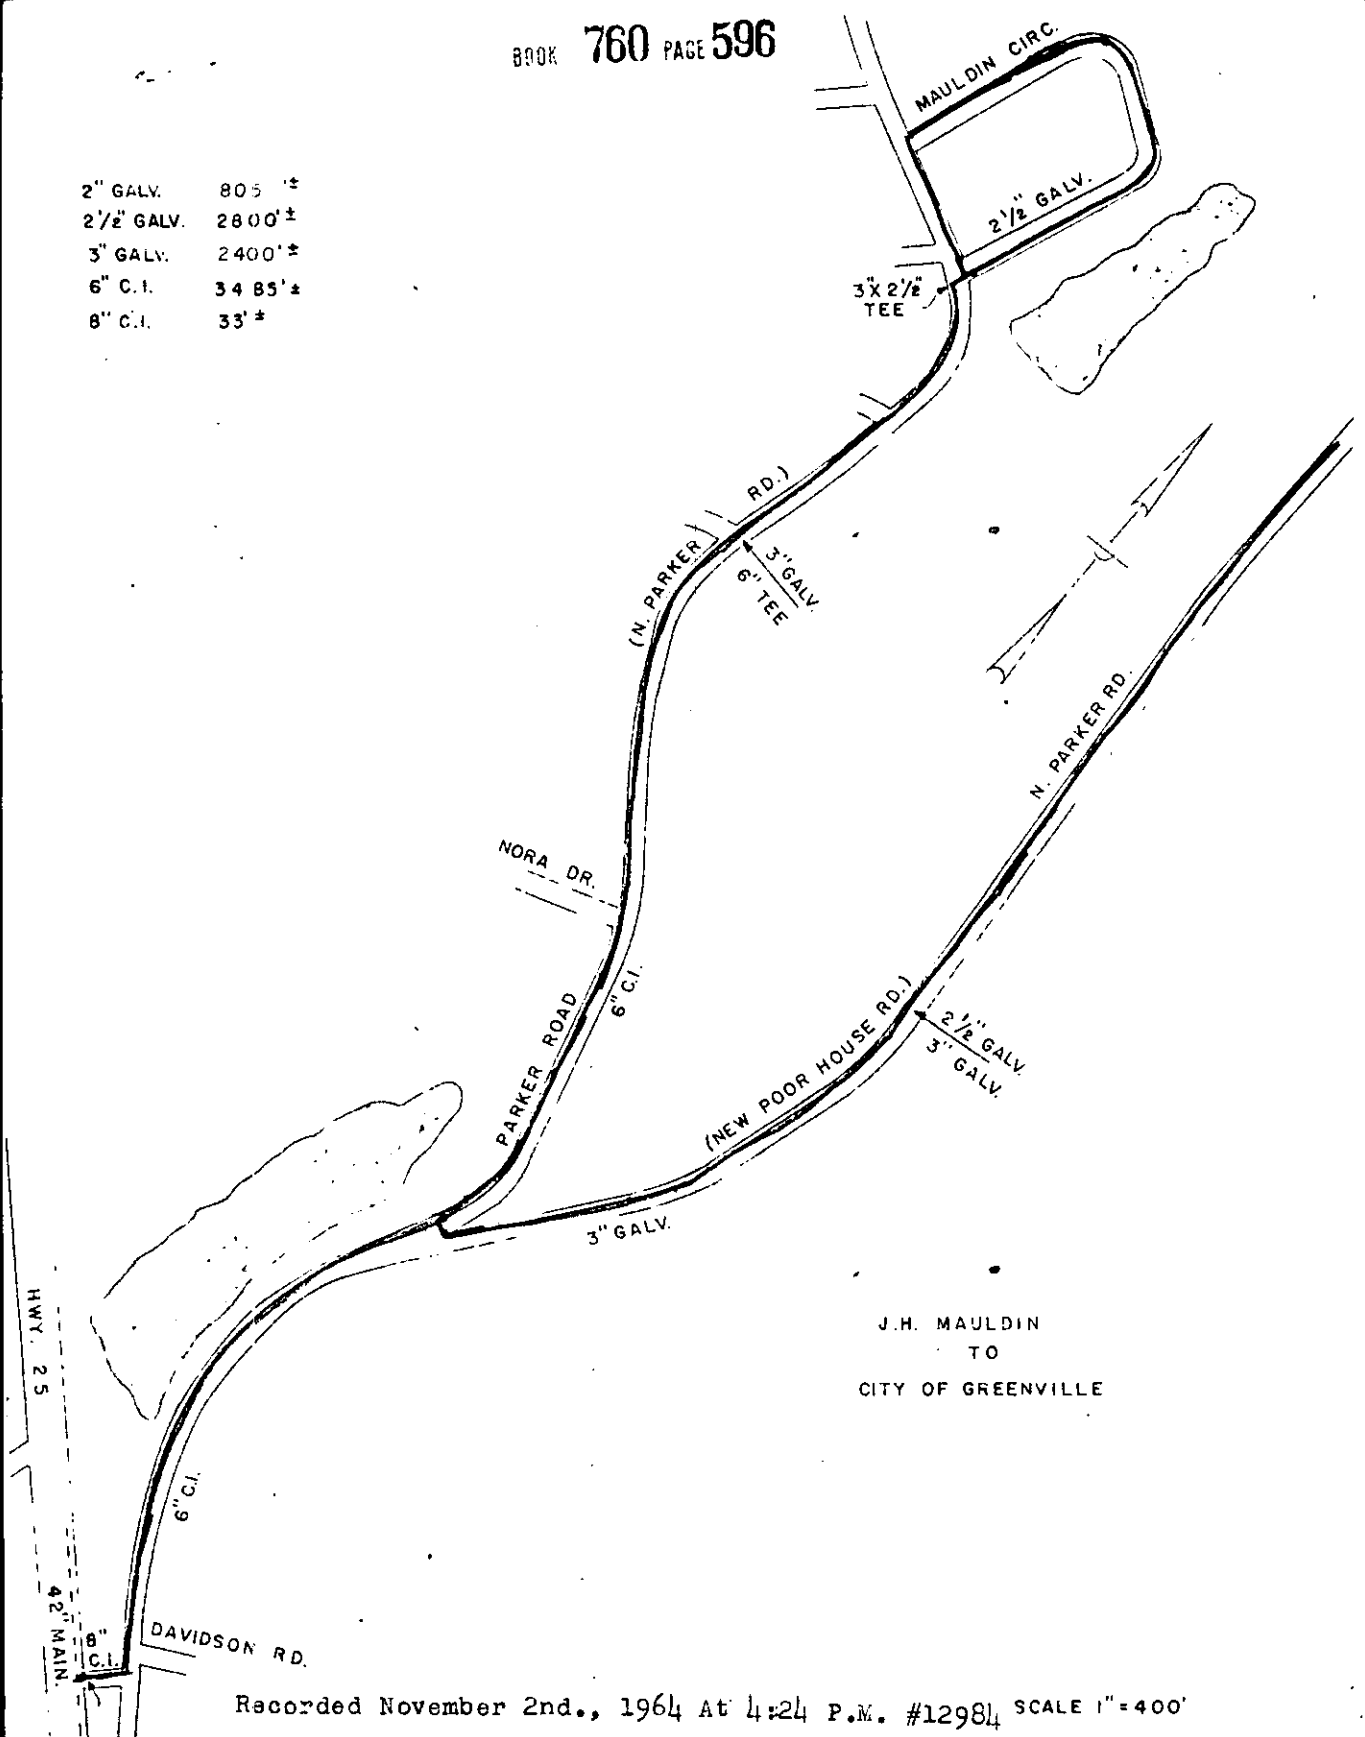

J.H. MAULDIN
TO
CITY OF GREENVILLE

Recorded November 2nd., 1964 At 4:24 P.M. #12984 SCALE 1"=400'