




Recorded February 8th., 1965 At 9:35 A.M. # 22336

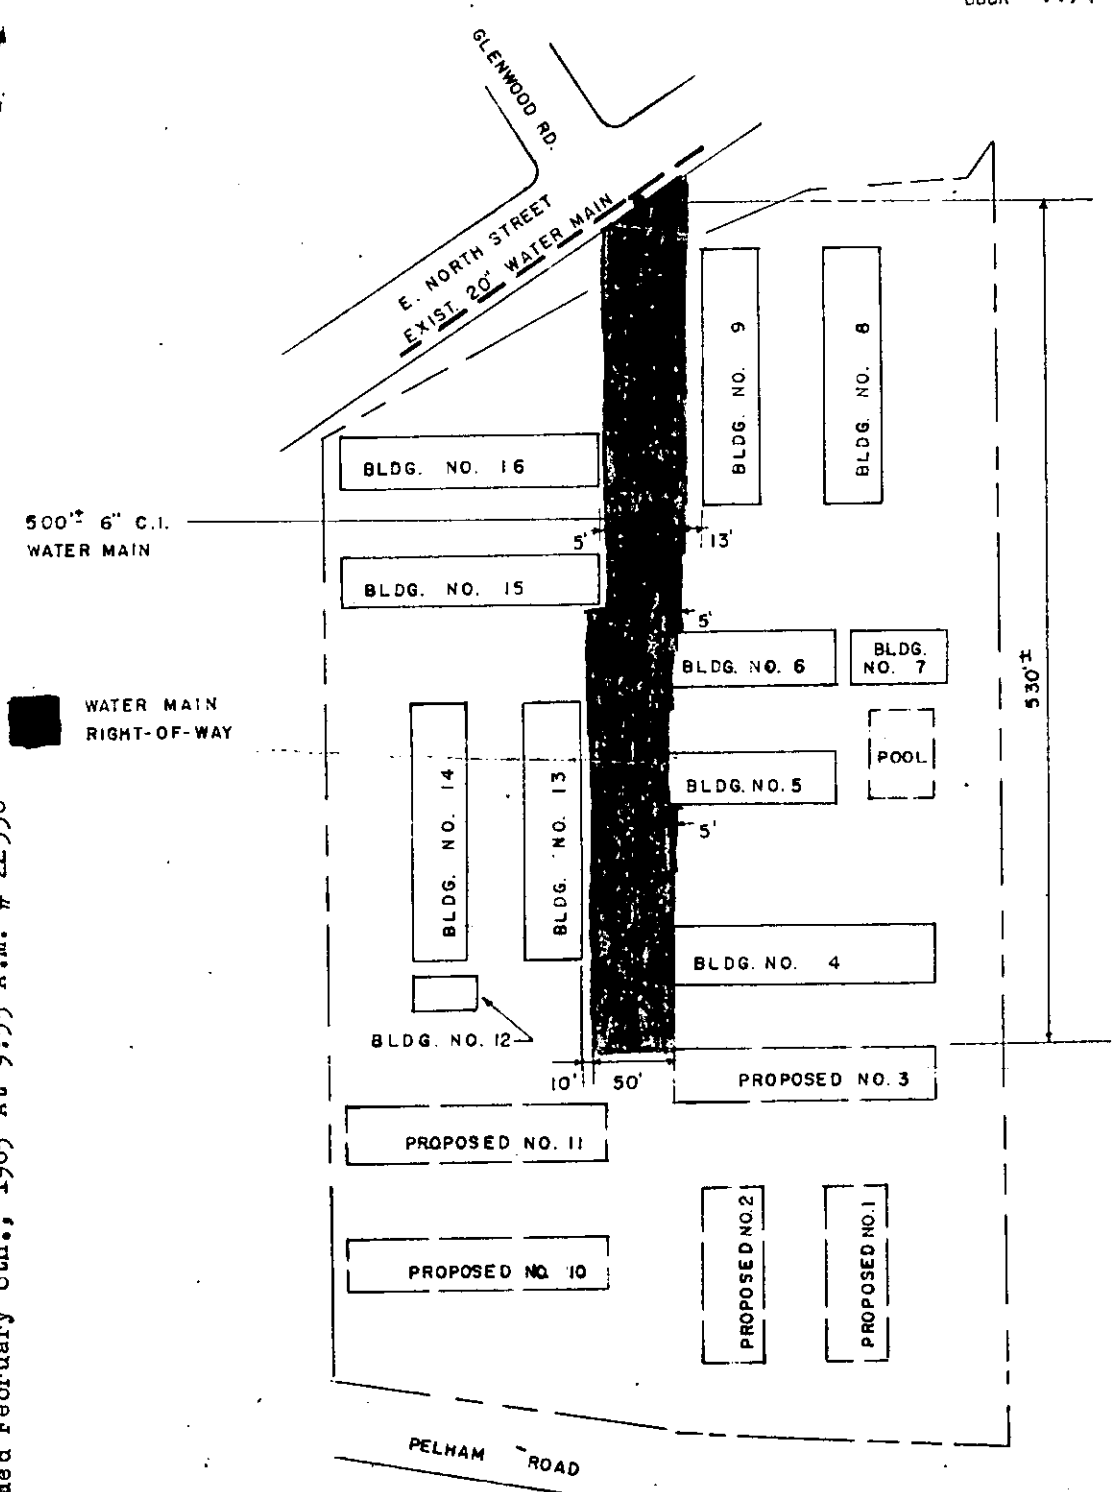

YORKTOWN OF GREENVILLE
LIMITED PARTNERSHIP
TO
CITY OF GREENVILLE, S.C.
FEBRUARY 3, 1965

YORKTOWN APARTMENTS

1" = 100'