


PIEDMONT NATURAL GAS CO INC

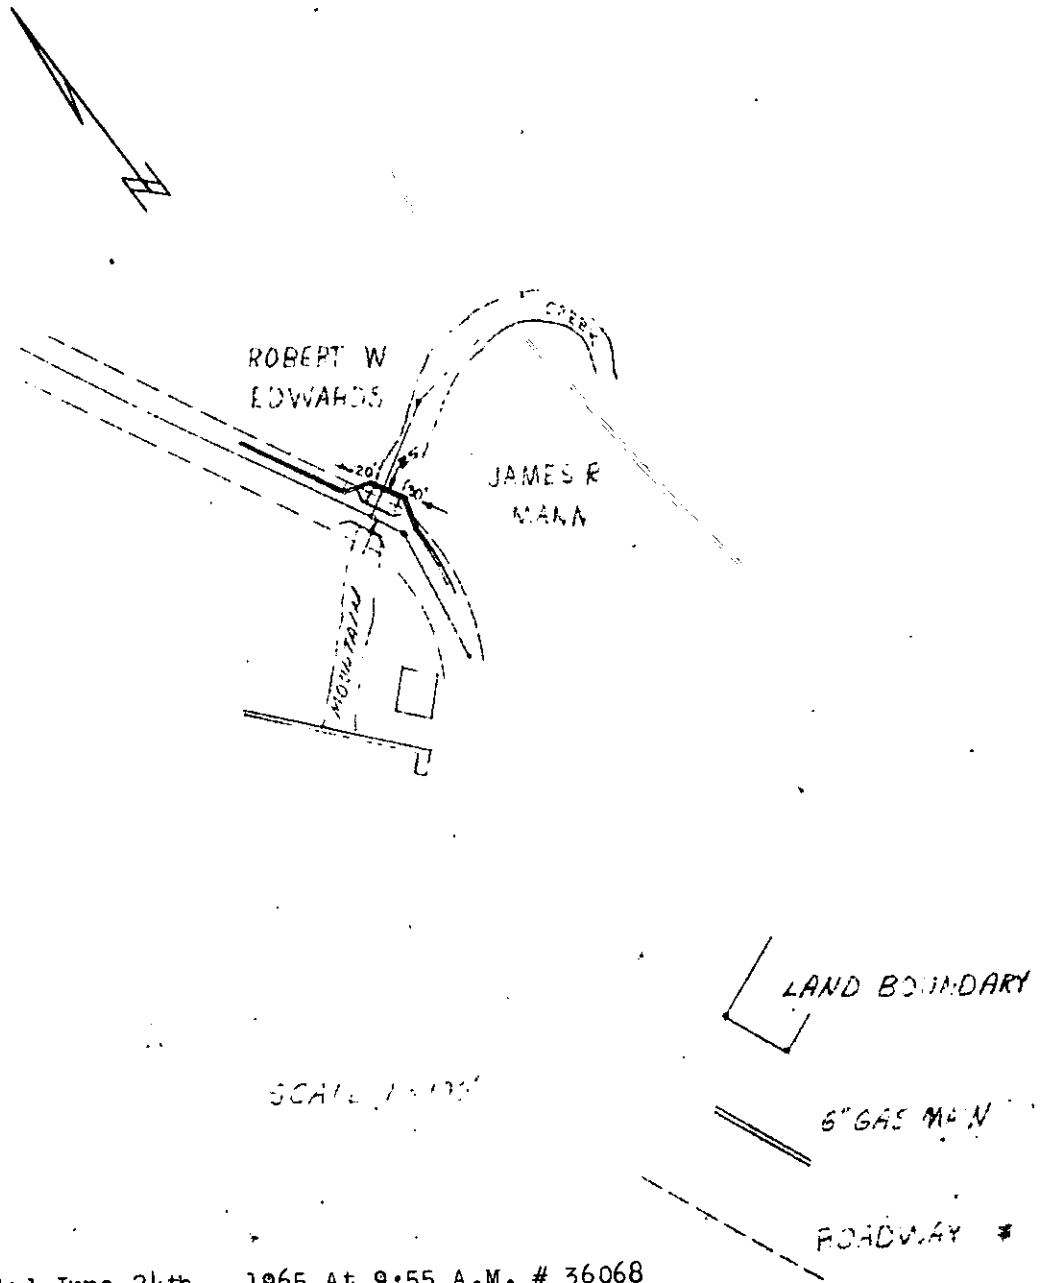

Recorded June 24th., 1965 At 9:55 A.M. # 36068