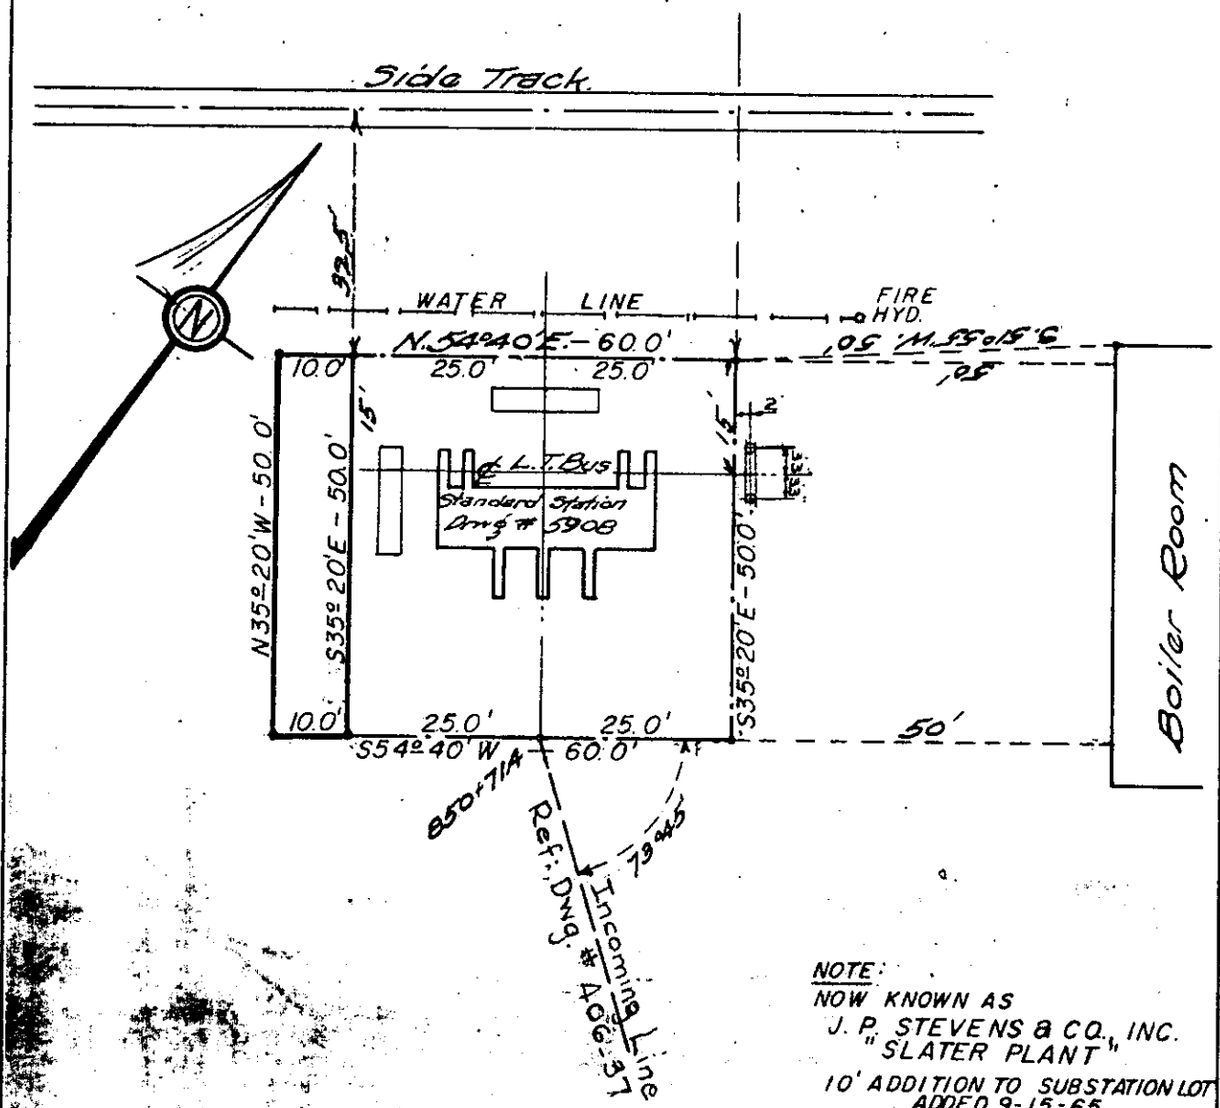

NOTE:
NOW KNOWN AS
J. P. STEVENS & CO., INC.
"SLATER PLANT"
10' ADDITION TO SUBSTATION LOT
ADDED 9-15-65

Southern Power Co.
Substation Lot
J.P. Stevens & Co. Inc.
"Slater Plant"
Marietta, S.C.
Greenville County

Scale: 1"=20' Oct 27 1927
Surveyed by F.R. Davis File No. 4-49

Recorded October 21, 1965 At 9:30 A.M. # 13002

FILE No. 6.90

BOOK 10 PAGE 27