


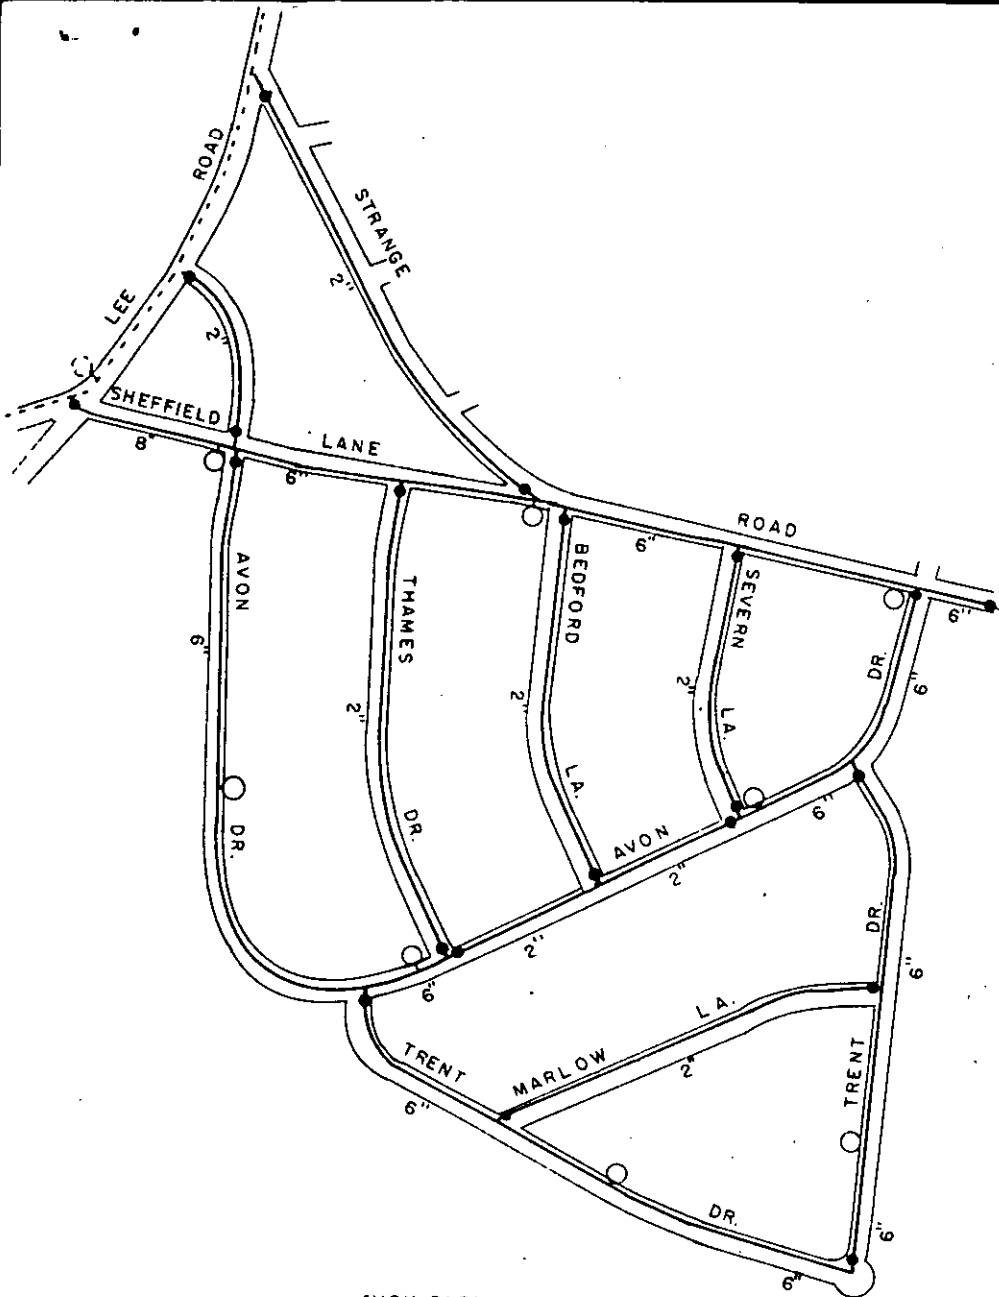

SCALE 1" = 400'



AVON PARK

Material List

- 7427' of 6" C. I. Pipe
- 440' of 8" C. I. Pipe
- 6450'± of 2" Galv. Pipe
- 1 - 8" Valve
- 15 - 2" Valves
- 14 - 6" Valves
- 8 - Fire Hydrants

L. H. Tankersley
To
City Of Greenville

Recorded April 11th., 1966 At 11:01 A.M. # 29167