


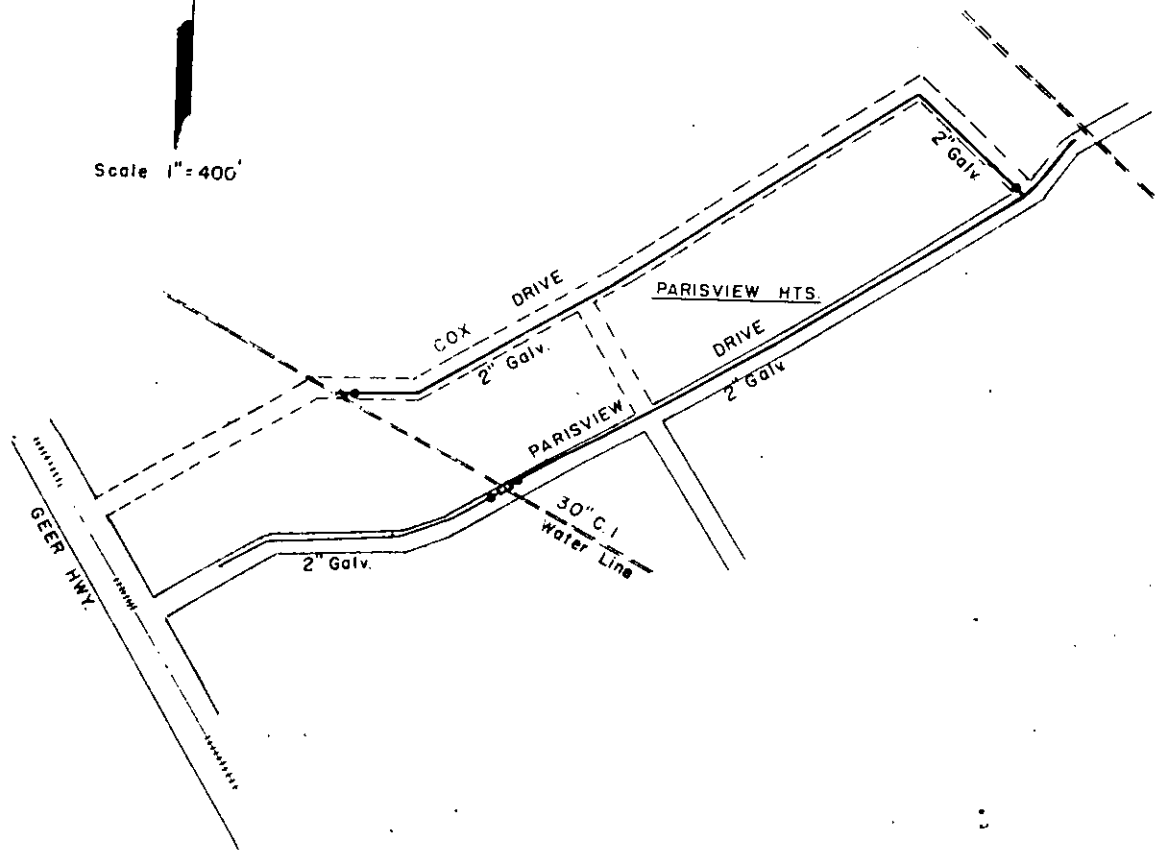

Scale 1" = 400'



MATERIAL LIST

4185' of 2" Galv. Pipe

4 - 2" Valves

L. H. TANKERSLEY

TO

CITY OF GREENVILLE

3-8-66

No. 17

Recorded May 20th., 1966 At 4:23 P.M. # 33229