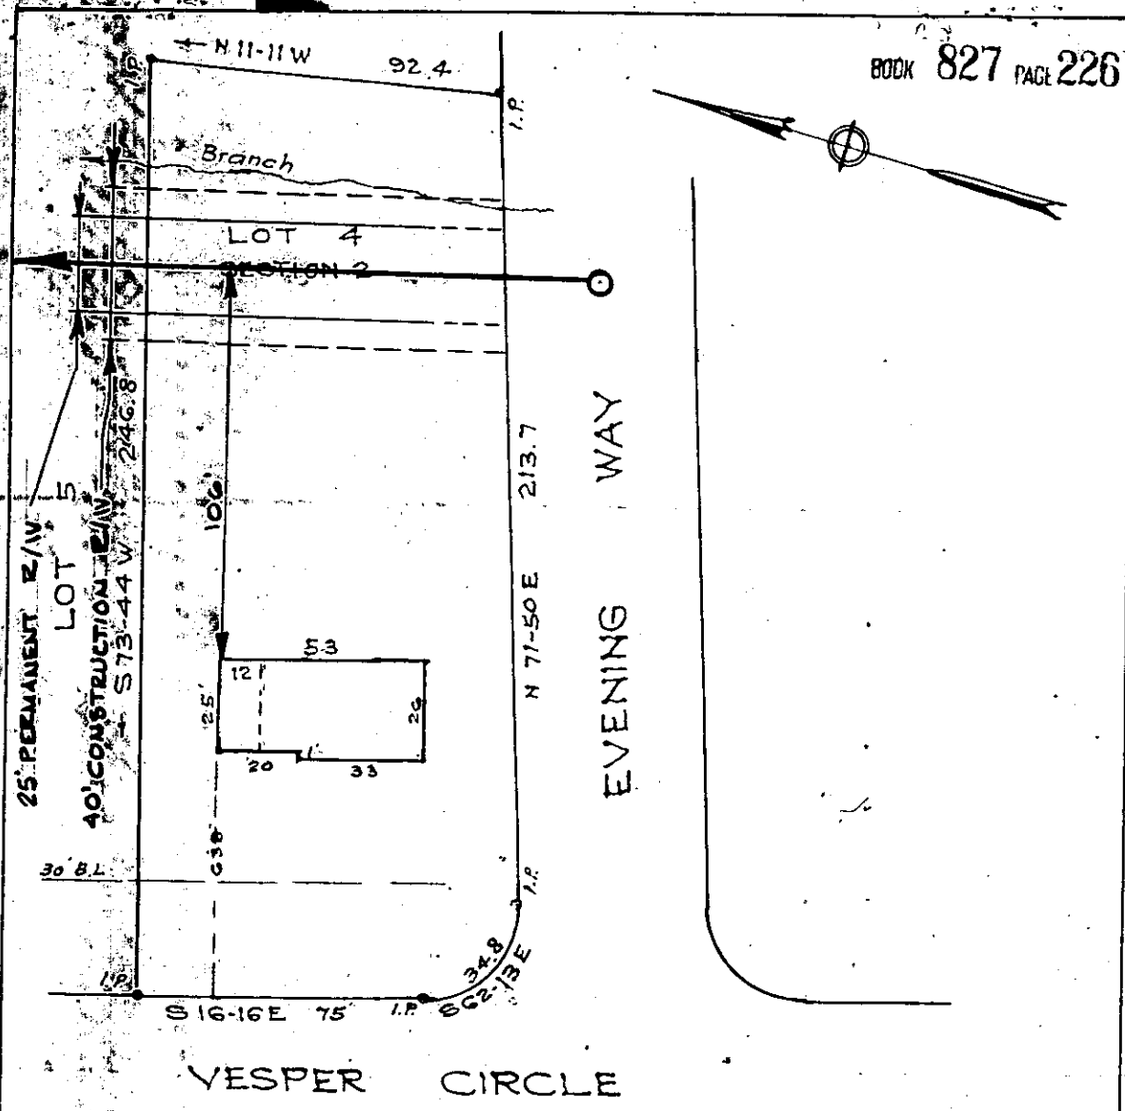

PROPERTY OF

WILLARD E. YEAGER

MAULDIN, S. C.

Scale 1"=40' Nov. 1961

C-JH-647 4144

This is to certify that on the 24th day of November, 1961, I surveyed the property shown on this plat; being known as Lot 4, Section 2 on plat of Sunset Heights, Recorded in Plat Book RR page 85, Office of R. M. C. Greenville Co., S. C.; and that the property lines, walls and buildings are as shown hereon; that the buildings located on said lot do not encroach or project on adjacent streets or property; and that no adjacent buildings or walls encroach or project on saud premises.

K. W. Dalton

Dalton & Neves, Engineers.

Recorded August 30th., 1967 At 3:08 P.M. # 6469.

34846