
N L

SCALE 1'=100'

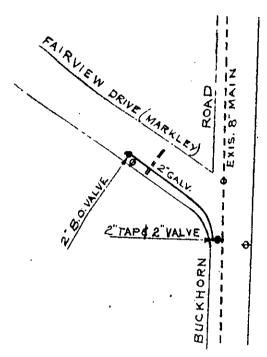

## MATERIAL LIST

153'±of 2" Galv, Pipe

2 - 2" Gate Valves

Hubert Rainey

TO

Piedmont Park Fire Dist

Recorded October 24, 1967 At 3:12 P.M. # 11933