


N

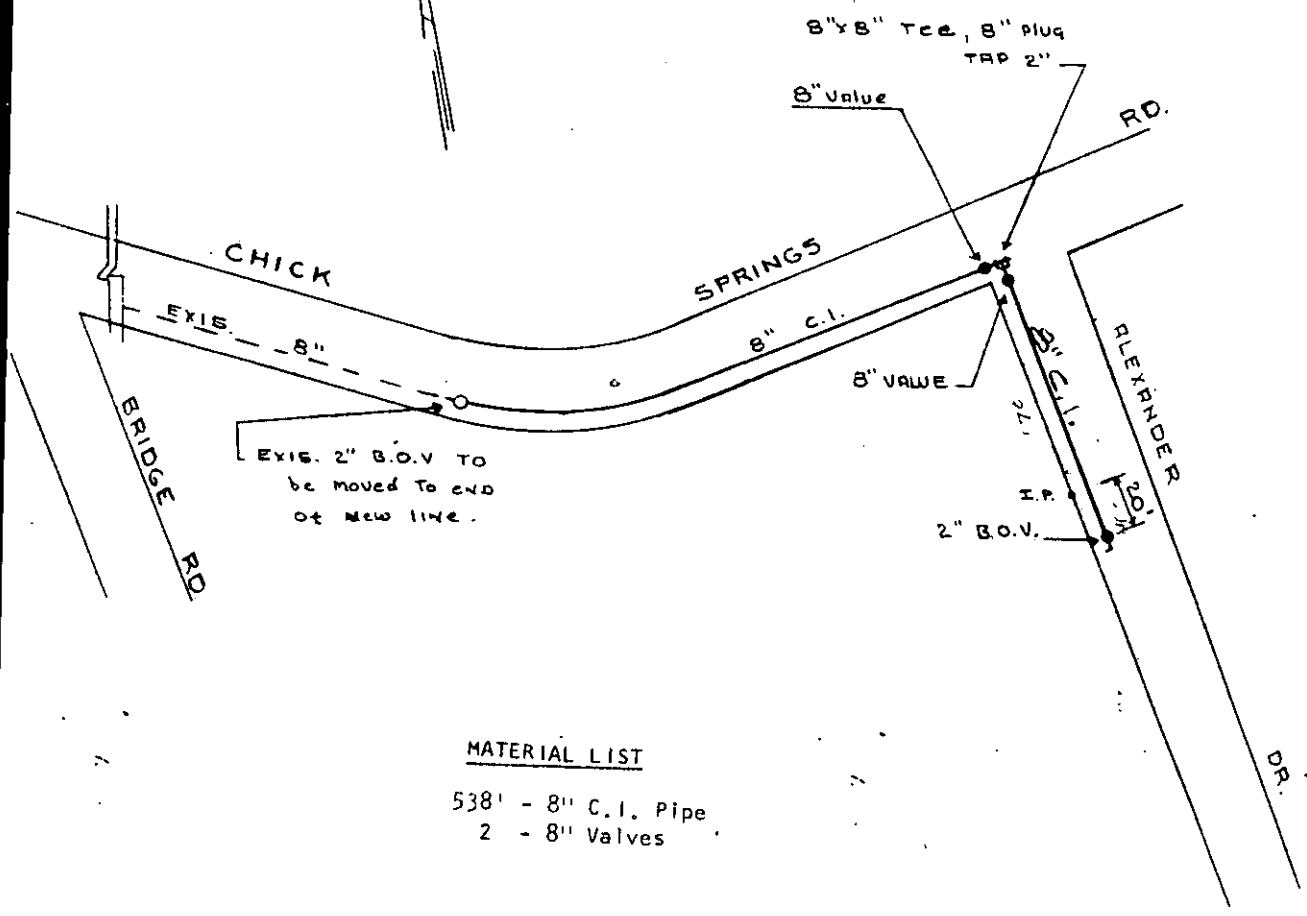

MATERIAL LIST

- 538' - 8" C.I. Pipe
- 2 - 8" Valves

Mr. R. J. Nichols

TO

City of Greenville, S.C.

Recorded May 30, 1968 At 9:41 A.M. # 30829

SCALE 1" = 100'  
5-3-68