


DEC 2 - 1968

GREENVILLE CO. S.C.

BOOK 857 PAGE 231

DEC 2 1 to PM 1968

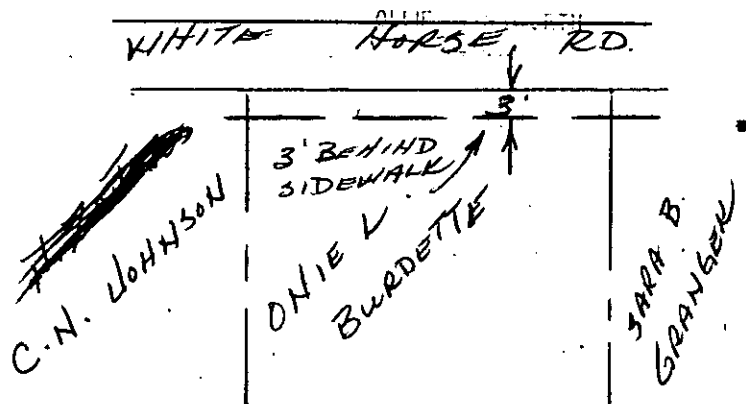

Name and Address of Grantor: ONIE L. BURDETTE  
 WHITE HORSE ROAD  
 GREENVILLE, S.C.  
 Property Covered by this Permit: GREENVILLE, S.C.  
 Exchange: GREENVILLE, S.C.  
 Street: WHITE HORSE ROAD  
 Diagram showing location of property as related to streets or other known land marks:  
 Authority: S. 3260 Classification: 45-C  
 Area: GREENVILLE  
 Approved: [Signature]  
 Title: Deputy Mayor

GEP 47.101 XX 5 = 5.09 13262 EXCHANGE PLANT PERMIT (INDIVIDUAL) Form 8418 Mar. '56

Received of the SOUTHERN BELL TELEPHONE AND TELEGRAPH COMPANY NO /100 Dollars, in consideration of which (I) (~~we~~) hereby grant said Company, its associated and allied companies, their respective successors and assigns, the right, privilege and authority to construct, operate and maintain its lines of telephone and telegraph, and for the general transmission of intelligence and/or for the purpose of the transmission and distribution of electric power, consisting of: BURIED CABLE

and fixtures with the further right to permit the attachment of wires of any other Company, or persons, to said poles and fixtures UNDER the property which (I) (~~we~~) own, or have an interest, located in the City of GREENVILLE, County of GREENVILLE, and State of SOUTH CAROLINA, to-wit: THAT TRACT OF LAND BOUNDED ON THE NORTH BY THE PROPERTY OF SARA B. GRANGER, ON THE SOUTH BY THE PROPERTY OF C.N. JOHNSON AND ON THE WEST BY WHITE HORSE ROAD.

Executed November 1, 1968 (Post Office Address)  
Onie L. Burdette (L. S.)  
 Witness: Joe J. Burgess (L. S.)  
Ralph M. Burdette (L. S.)  
RALPH M. BURDETTE ONIE L. BURDETTE

**ACKNOWLEDGMENTS**  
 For Use in South Carolina

Individual Form

STATE OF SOUTH CAROLINA }  
 COUNTY OF Greenville } ss.

Personally appeared before me JOEL F. BURGESS and made oath that (he) (~~she~~), with RALPH M. BURDETTE saw the within named ONIE L. BURDETTE

sign, seal, and deliver as (his) (her) (their) act and deed the within written instrument, and that (he) (she) with the said RALPH M. BURDETTE witnessed the execution thereof.

Sworn to before me this 8 day of November, A.D. 1968  
[Signature]  
 Notary Public

Joel Burgess  
 Right of Way Recorded December 2, 1968 At 1:10 P.M. # 13262

As per 1-1-70