


FILED
GREENVILLE S.C.
DEC 2 - 1968

BOOK 857 PAGE 235

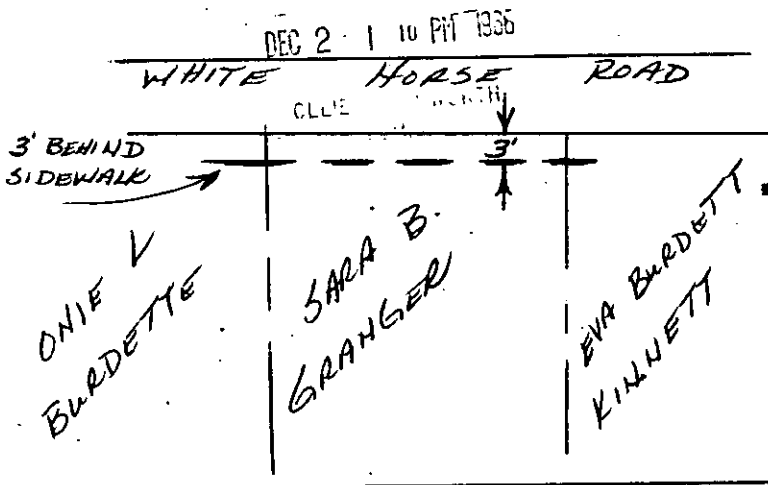

Name and Post Office Address of Grantor: SARA B. GRANGER
WHITE HORSE ROAD
 Property Covered by this Permit: GREENVILLE, S.C.
 Exchange: GREENVILLE, S.C.
 Street: WHITE HORSE RD Number: _____
 Diagram showing location of property as related to streets or other known land marks.
 Authority: 5-5760 Classification: 45-E
 Area: _____
 Approved: _____
 Title: _____

GEP 47.101 13262 EXCHANGE PLANT PERMIT (INDIVIDUAL) Form 8418 Mar. '66

Received of the SOUTHERN BELL TELEPHONE AND TELEGRAPH COMPANY ONE \$ No /100 Dollars, in consideration of which (I) (~~we~~) hereby grant said Company, its associated and allied companies, their respective successors and assigns, the right, privilege and authority to construct, operate and maintain its lines of telephone and telegraph, and for the general transmission of intelligence and/or for the purpose of the transmission and distribution of electric power, consisting of:

BURIED CABLE
 and fixtures with the further right to permit the attachment of wires of any other Company, or persons, to said poles and fixtures UNDER the property which (I) (~~we~~) own, or have an interest, located in the City of GREENVILLE, County of GREENVILLE, and State of SOUTH CAROLINA, to-wit:
THAT TRACT OF LAND BOUNDED ON THE SOUTH BY THE PROPERTY OF ONIE L. BURDETTE, ON THE NORTH BY THE PROPERTY OF EVA BURDETTE KINNETT AND ON THE WEST BY WHITE HORSE ROAD.

Executed November 2, 1968
 (Post Office Address)
Mrs. Harold Granger (L. S.)
 _____ (L. S.)
 _____ (L. S.)
 Witness: Joel J. Burgess
Harold Granger
N.E. SARA BURDETTE

GEP 47.101 Form 8426 Nov. '64

ACKNOWLEDGMENTS
 For Use in South Carolina

Individual Form

STATE OF SOUTH CAROLINA }
 COUNTY OF Greenville } ss.

Personally appeared before me JOEL F. BURGESS
 and made oath that (he) (~~she~~), with HAROLD GRANGER saw the within named
MRS. HAROLD GRANGER
 _____ sign,
 seal, and deliver as (his) (her) (their) act and deed the within written instrument, and that (he) (she) with the
 said HAROLD GRANGER witnessed the execution thereof.

Sworn to before me this 8 day of NOV. A.D. 1968
Joel Burgess
 Notary Public Expires 1-1-70
 Recorded December 2, 1968 At 1:10 P.M. # 13262