


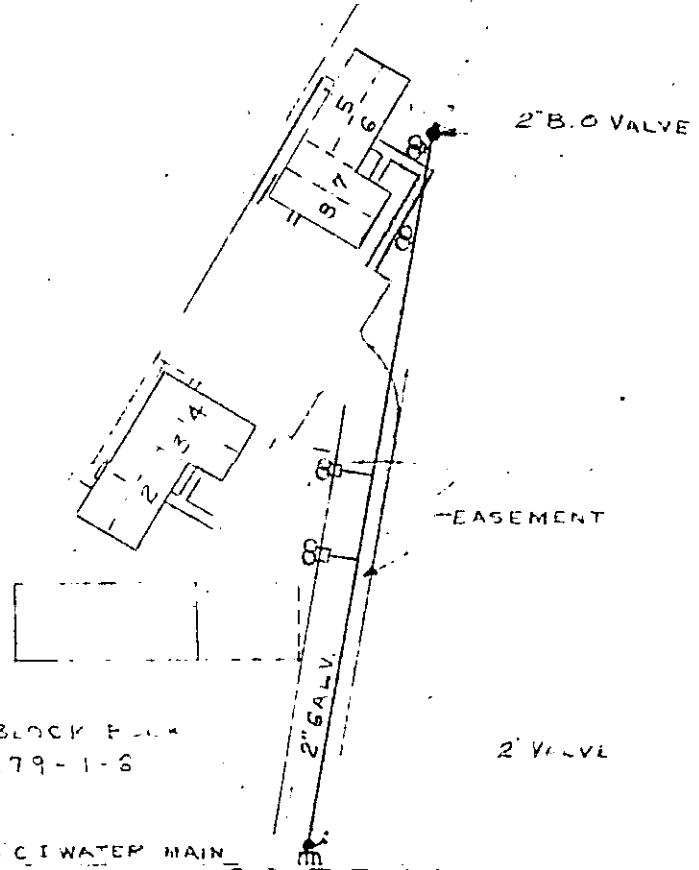

ROCK MOUNT PL.

BLOCK FOUR  
279-1-6

EXIST. 20" CI WATER MAIN  
OLD DEPARTMENTAL ROAD



Survey of  
Feather Corp  
in Green Hill  
Scale 1" = 70'  
February, 1969

recorded february 7th, 1969 at 10:02 a.m. #18766