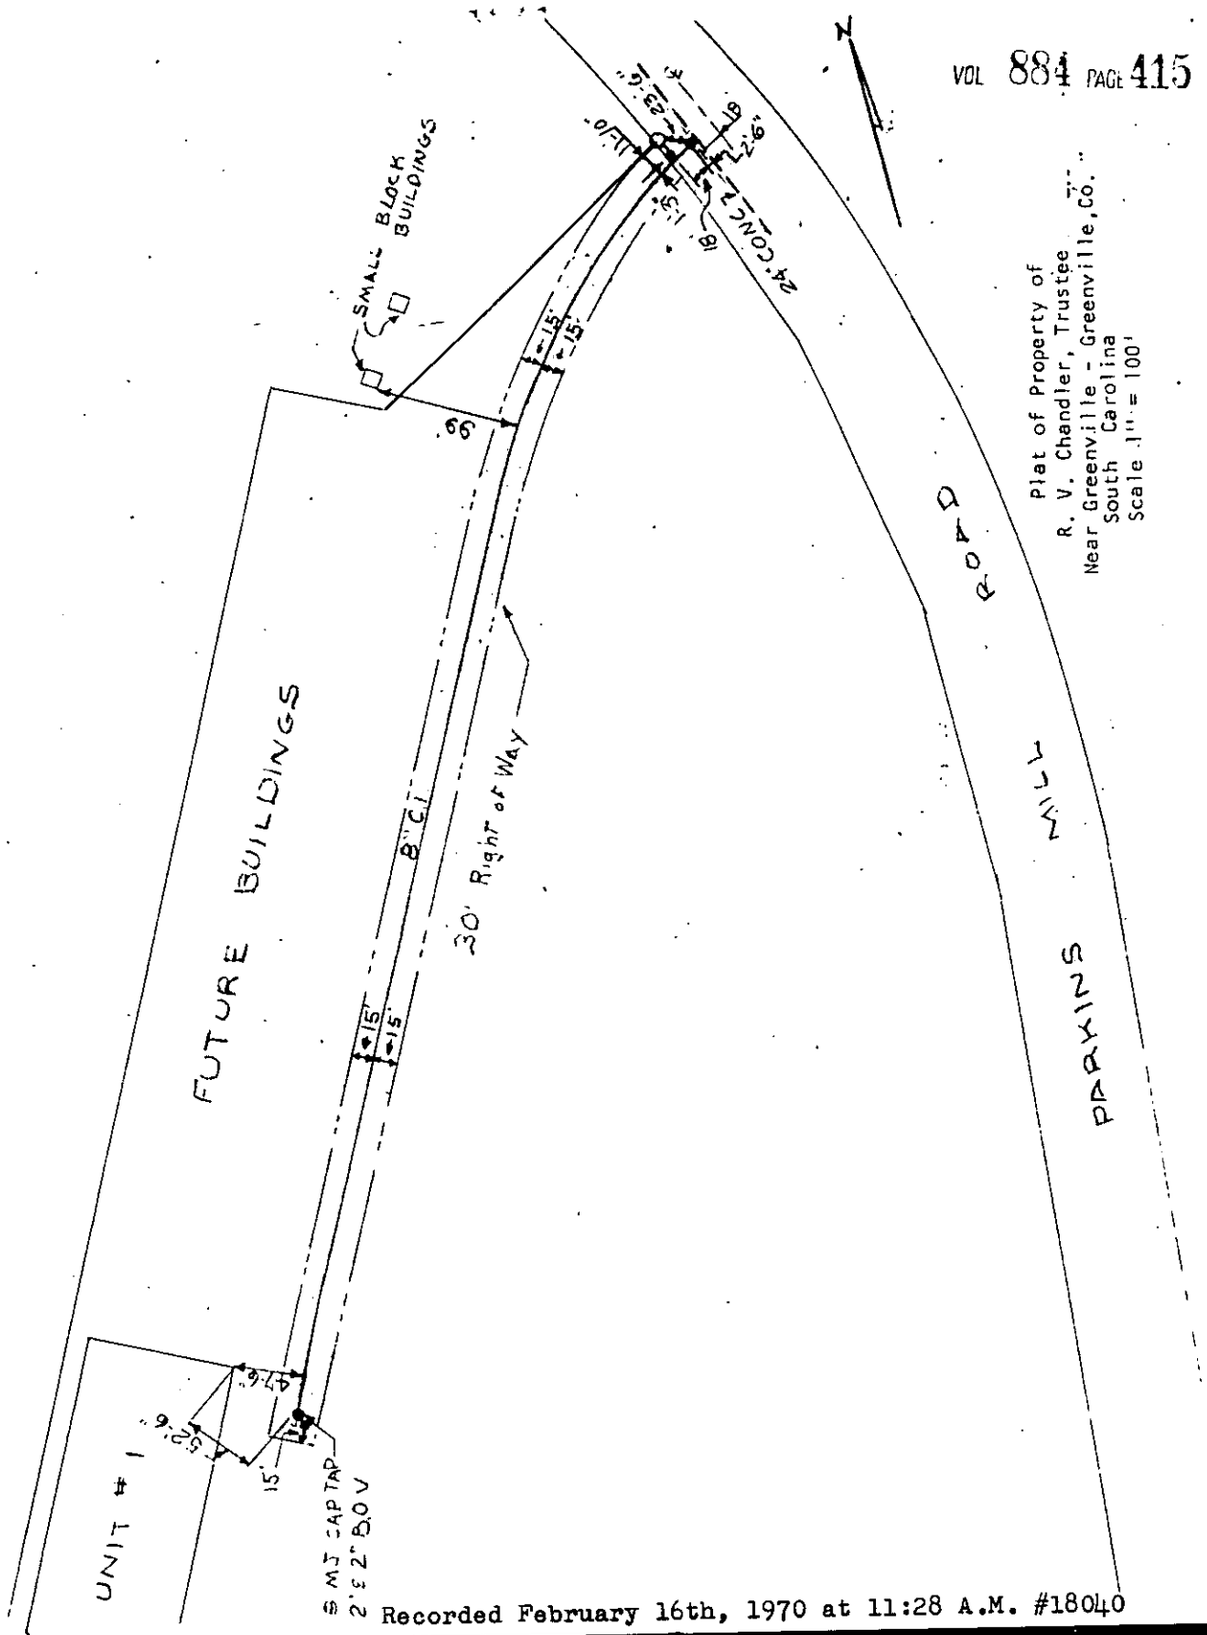

Recorded February 16th, 1970 at 11:28 A.M. #18040