


VOL 887 PAGE 474

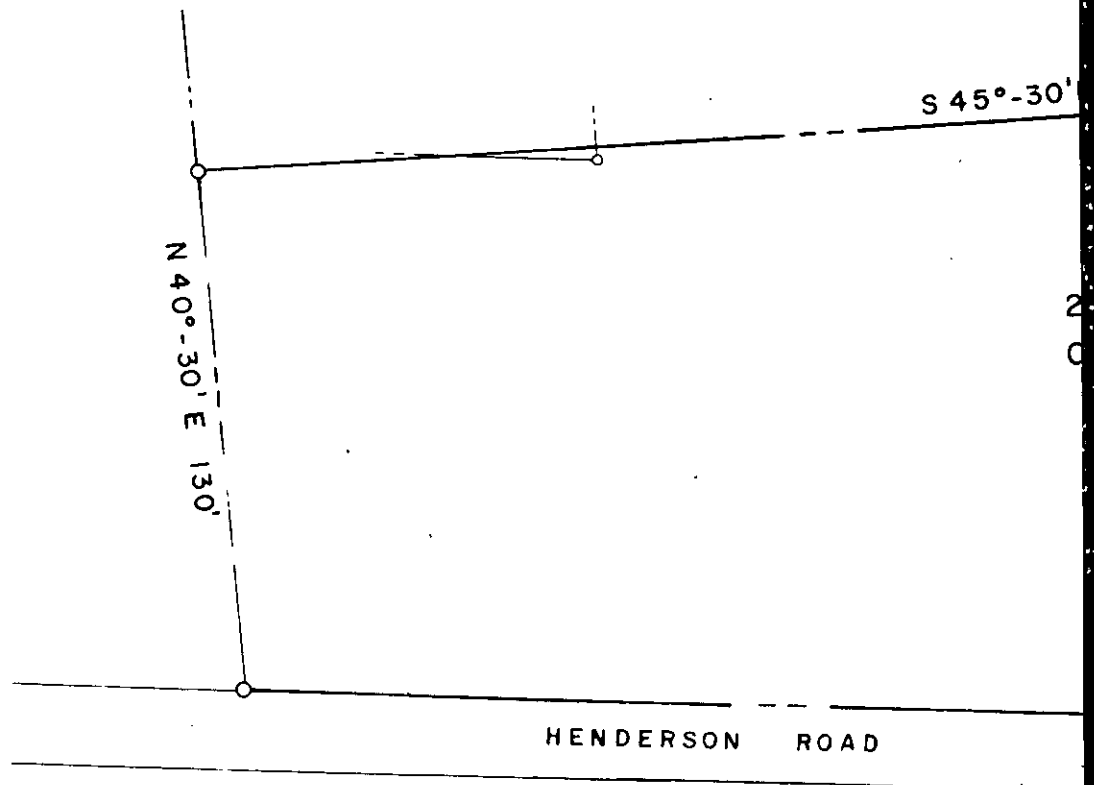

I CERTIFY THE LOCATION OF SEWER LINE  
ON THE ABOVE PROPERTY TO BE  
CORRECT TO THE BEST OF MY KNOWLEDGE.

OLD PROPERTY  
WERE OBTAIN  
GREENVILLE  
MAP NO. 490  
LOT 6.

S.C. REG. NO. 1574

				<b>DAVIS &amp; FLOYD ENGINEERS, INC.</b> GREENWOOD, S. C.		TAVE GREE
1	REVISED OWNER	J.M.M.	5-5-69			
NO.	REVISION	CHKD.	DATE			

(CONTINUED ON NEXT PAGE)