



505

NO PARKING

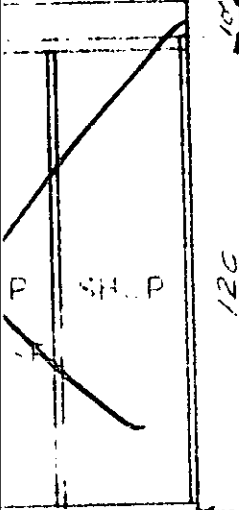

HFA -

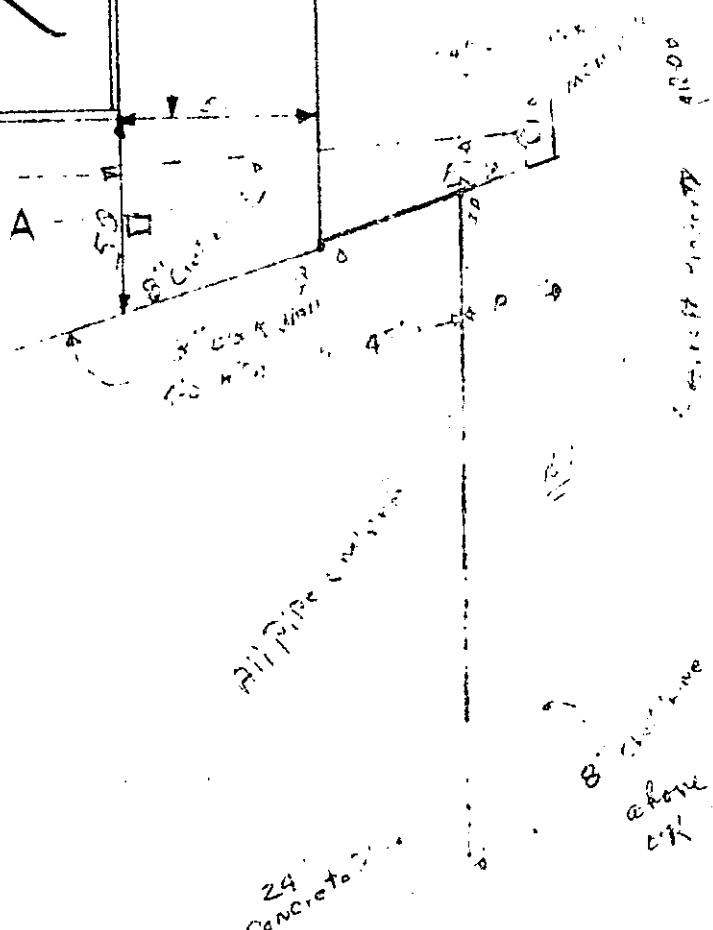

24" Concrete

8" concrete

CHK J.R. Smith for T.P. Cooper Jr.

Recorded April 17, 1970 At 4:17 P.M. # 22737

Street

REVISIONS			MAULIN PLAZA		
NO	DATE	BY	BI-LO INC.		
1					
2					
3			DRAWN BY <i>Jm</i>	SCALE <i>1/4"=1'-0"</i>	MATERIAL
4			CHK'D <i>J.R. Smith</i>	DATE <i>10-9-68</i>	DRAWING NO
5			TRACED	APP'D	<i>1.05</i>