

Form 1847

Development _____

See Dwg. _____

File No. _____

Subject _____


Sheet No. _____

of _____

By _____

Date _____

VOL 889 PAGE 150

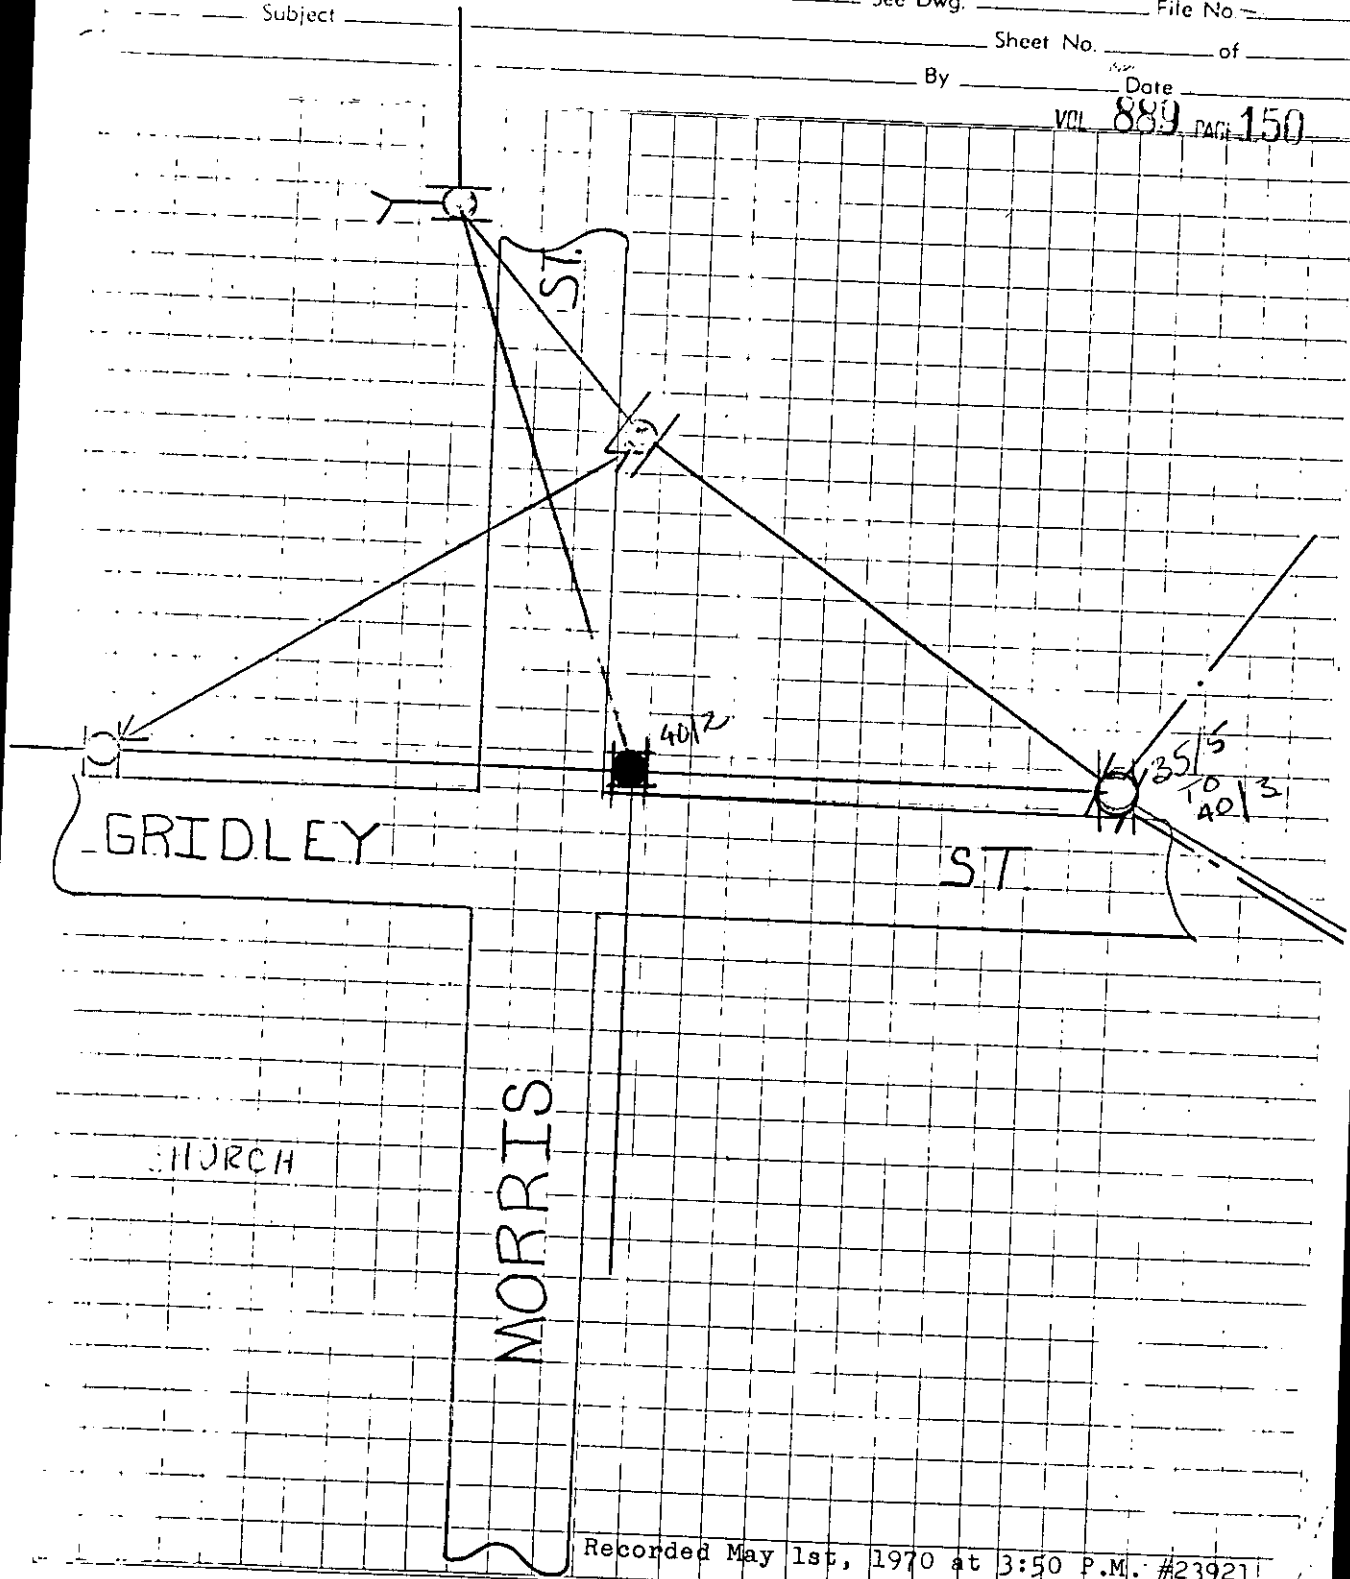

Recorded May 1st, 1970 at 3:50 P.M. #23921