


LAKESHORE

RD.

VOL 967 PAGE 40

12" C.I. WATER

780'
To E.I.R.S.

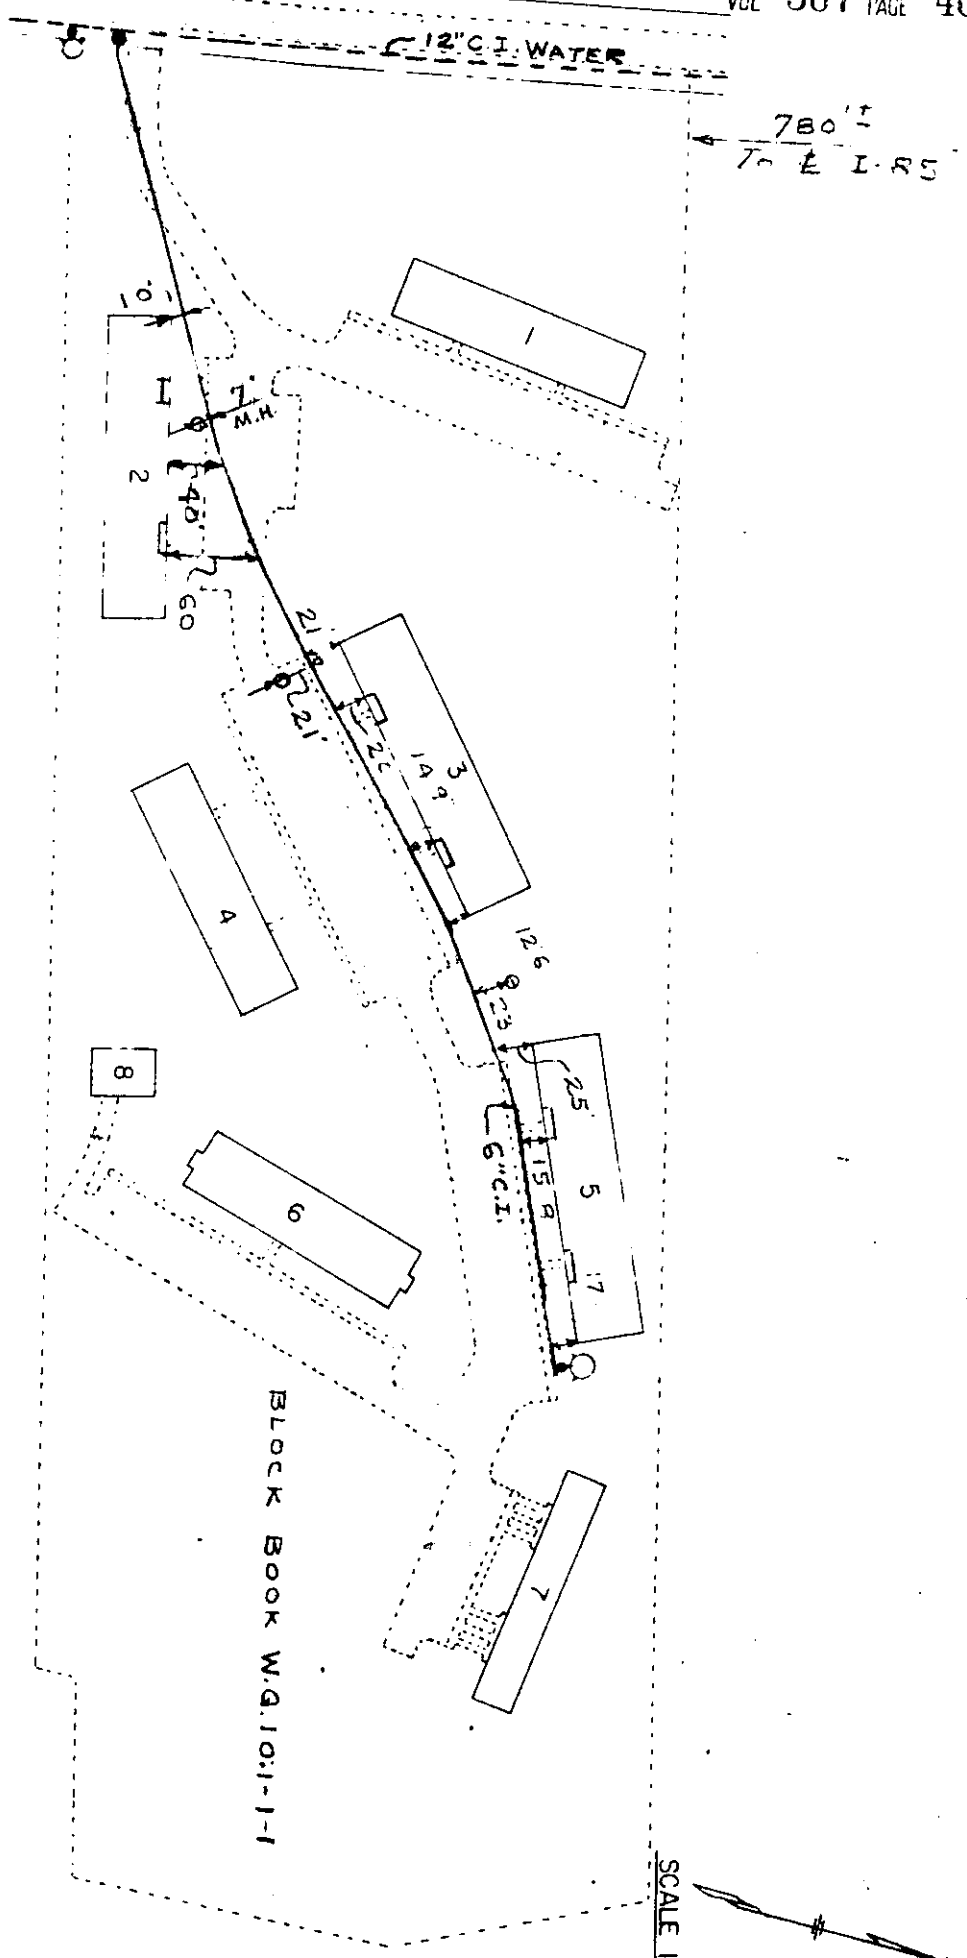

BLOCK BOOK W.G.10:1-1-1

LAKESHORE APTS.

OCTOBER, 1970

EASEMENT

Lakeshore Service Corporation

to

City of Greenville

SCALE 1"=100'

Recorded January 21, 1971 At 10:20 A.M. # 16878