
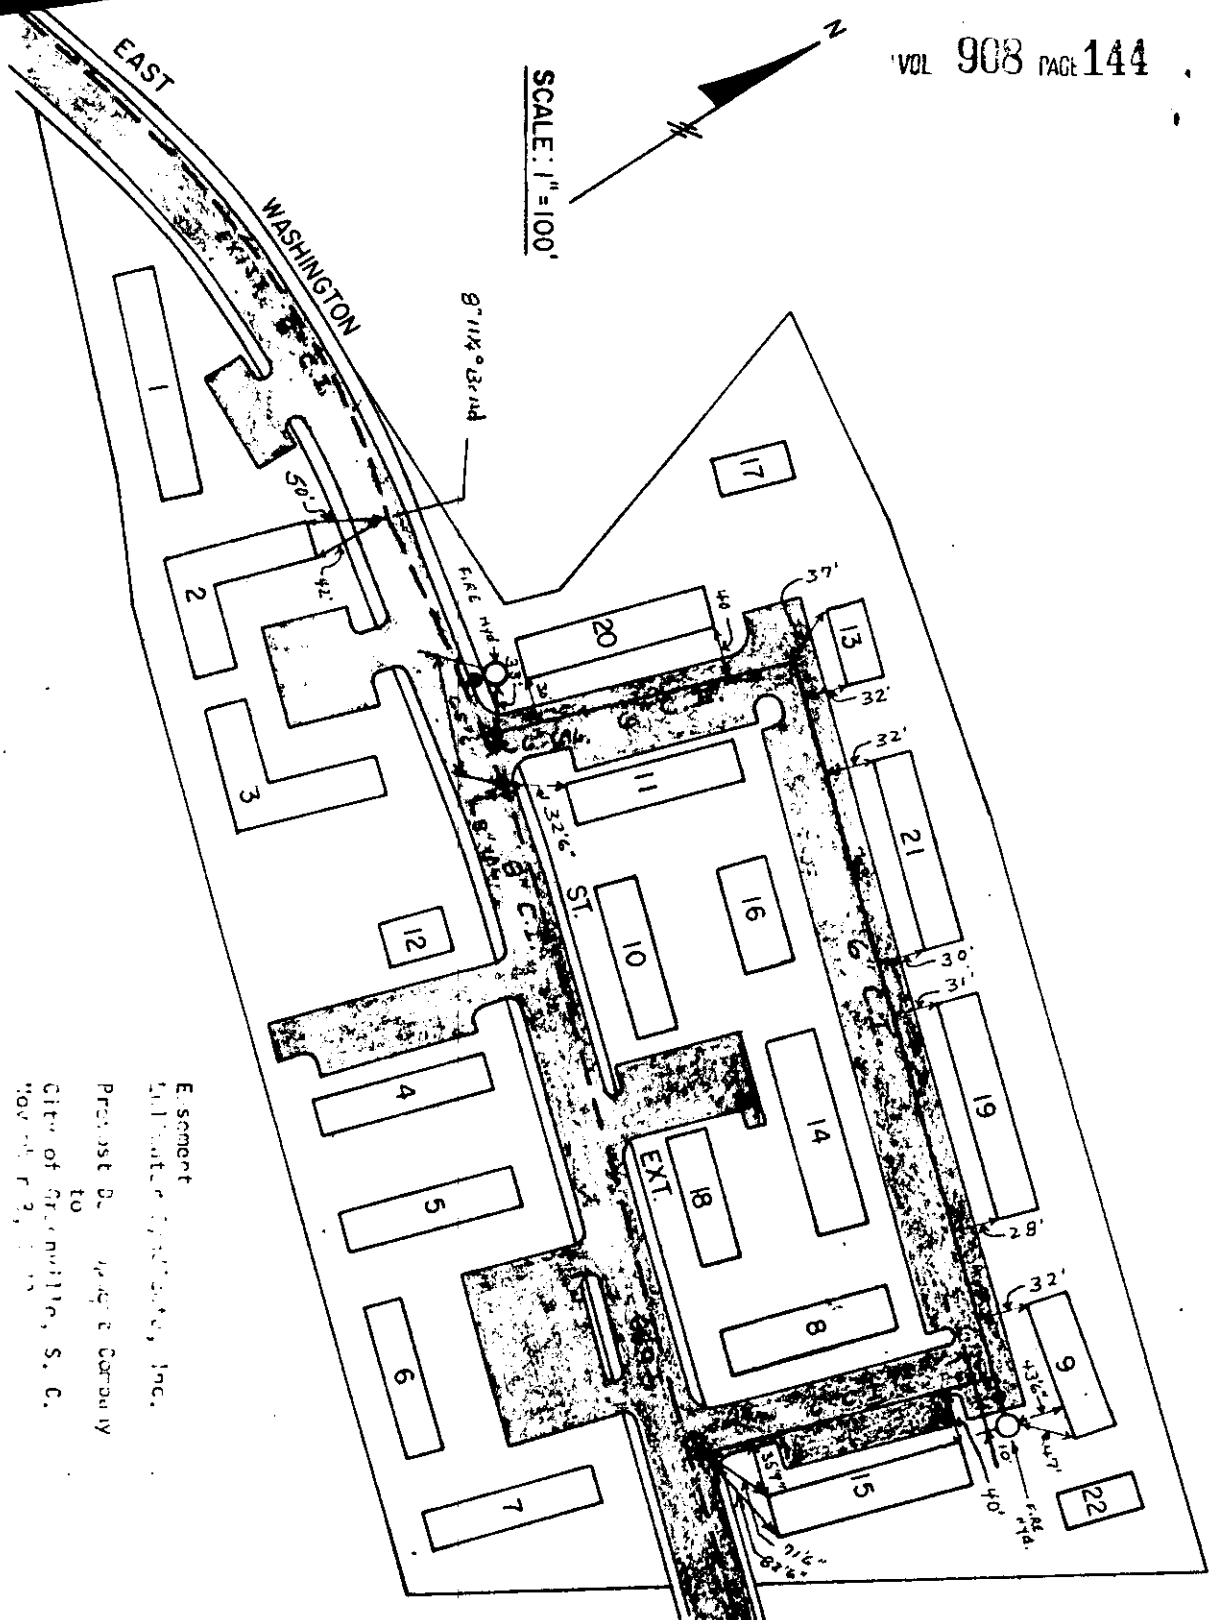


SCALE: 1" = 100'

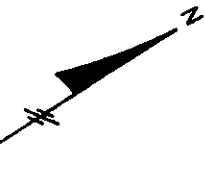

E. Somport  
 Precast Co. - Ready & Company  
 to  
 City of Greenville, S. C.  
 November 2, 1970

Plat Recorded February 5th, 1971 at 3:36 P.M. #18221