


SPARTANBURG COURT

DATE JULY, 1971

SCALE 1"=50'

NOTE: PLEASE REFER TO
E.C. 11-6
APPROX. SEE PLAT

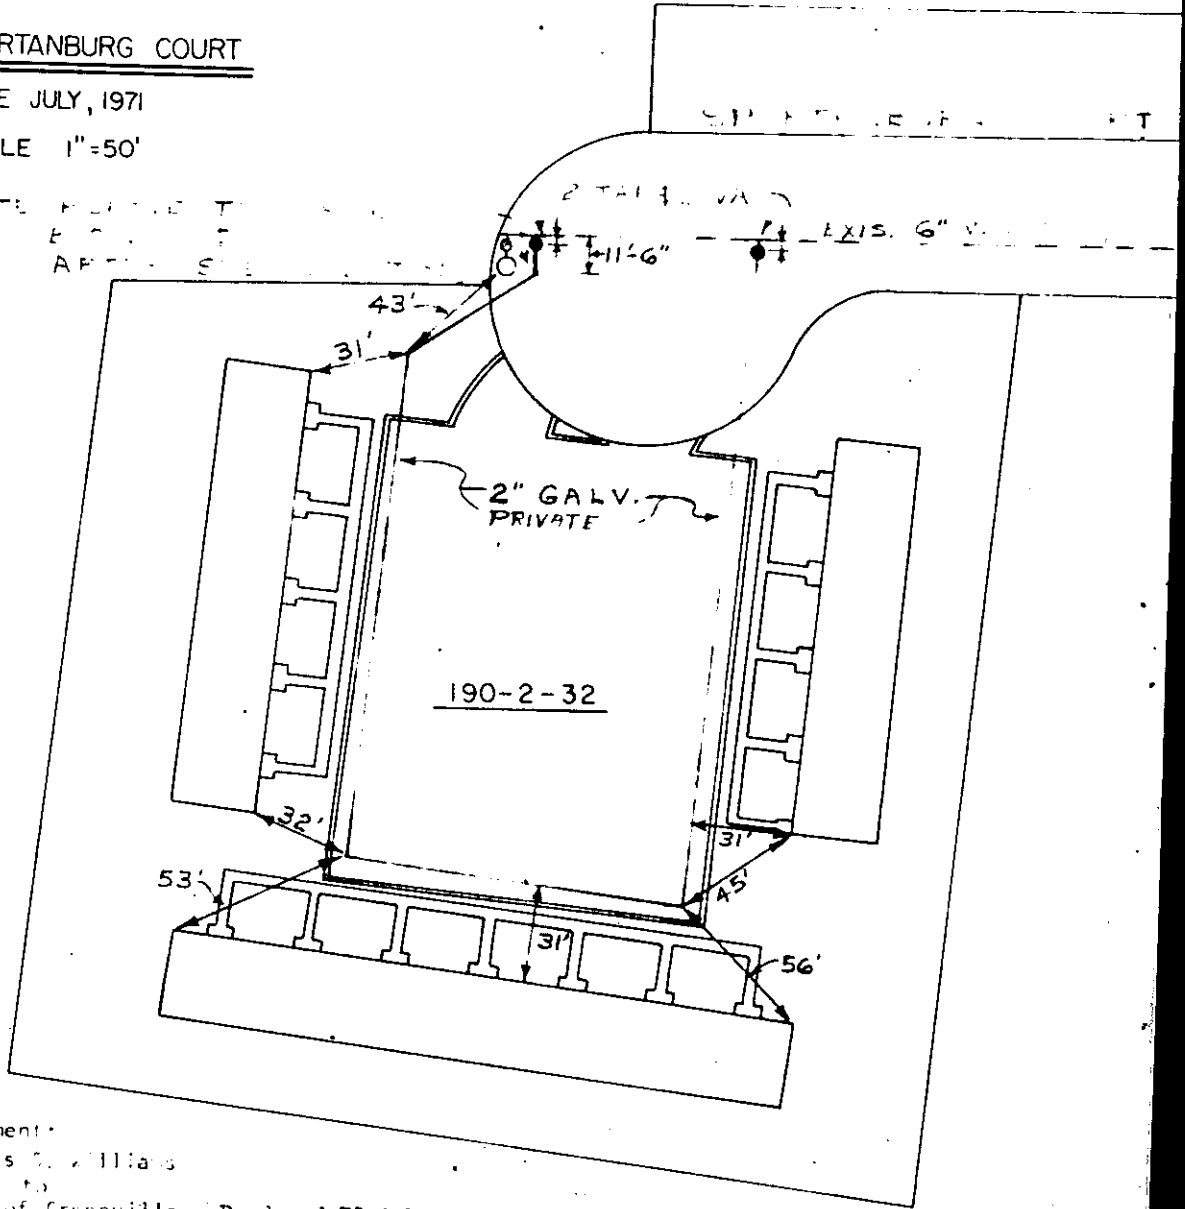

Easement:

Gladys S. Williams

to

City of Greenville Deed and Plat Recorded January 13, 1972 at 11:07 A. M., #190hh

January 3, 1972