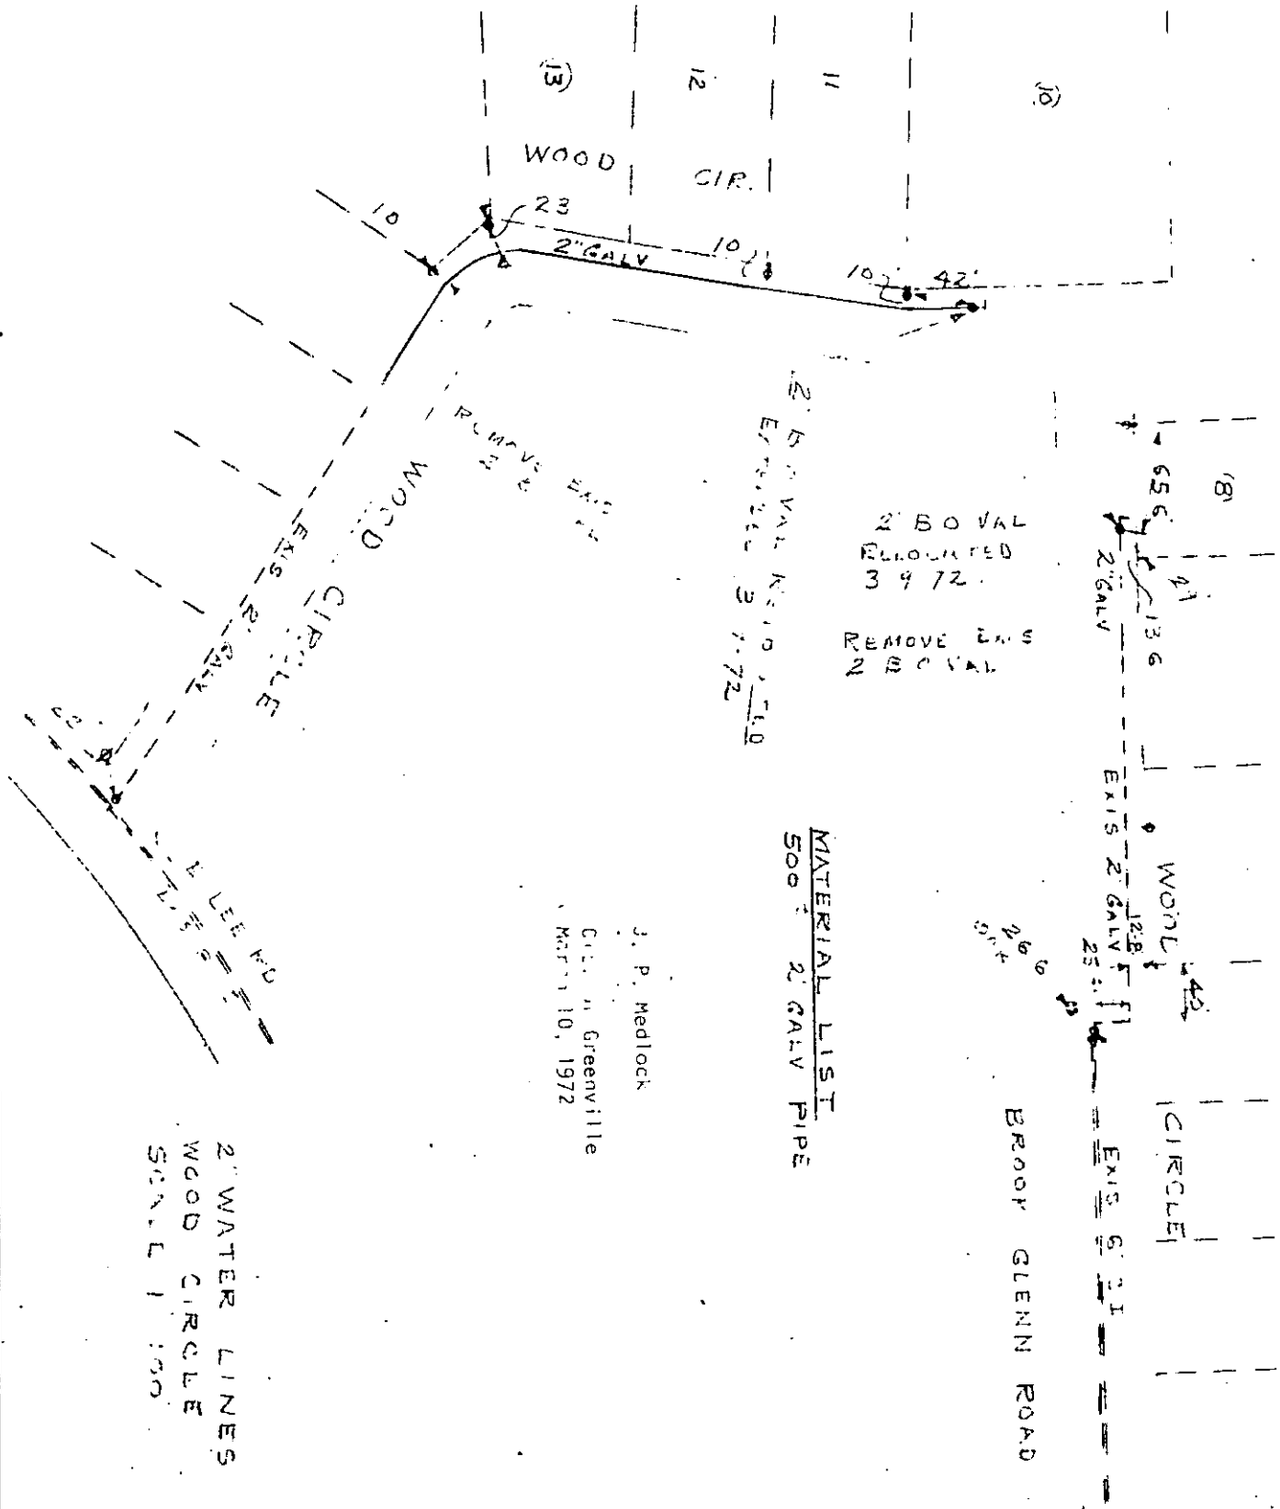

For Plat and Deed Recorded April 3, 1972 at 2:55 P. M., #26512