


BLK. BK. NO. B15-2-51.3

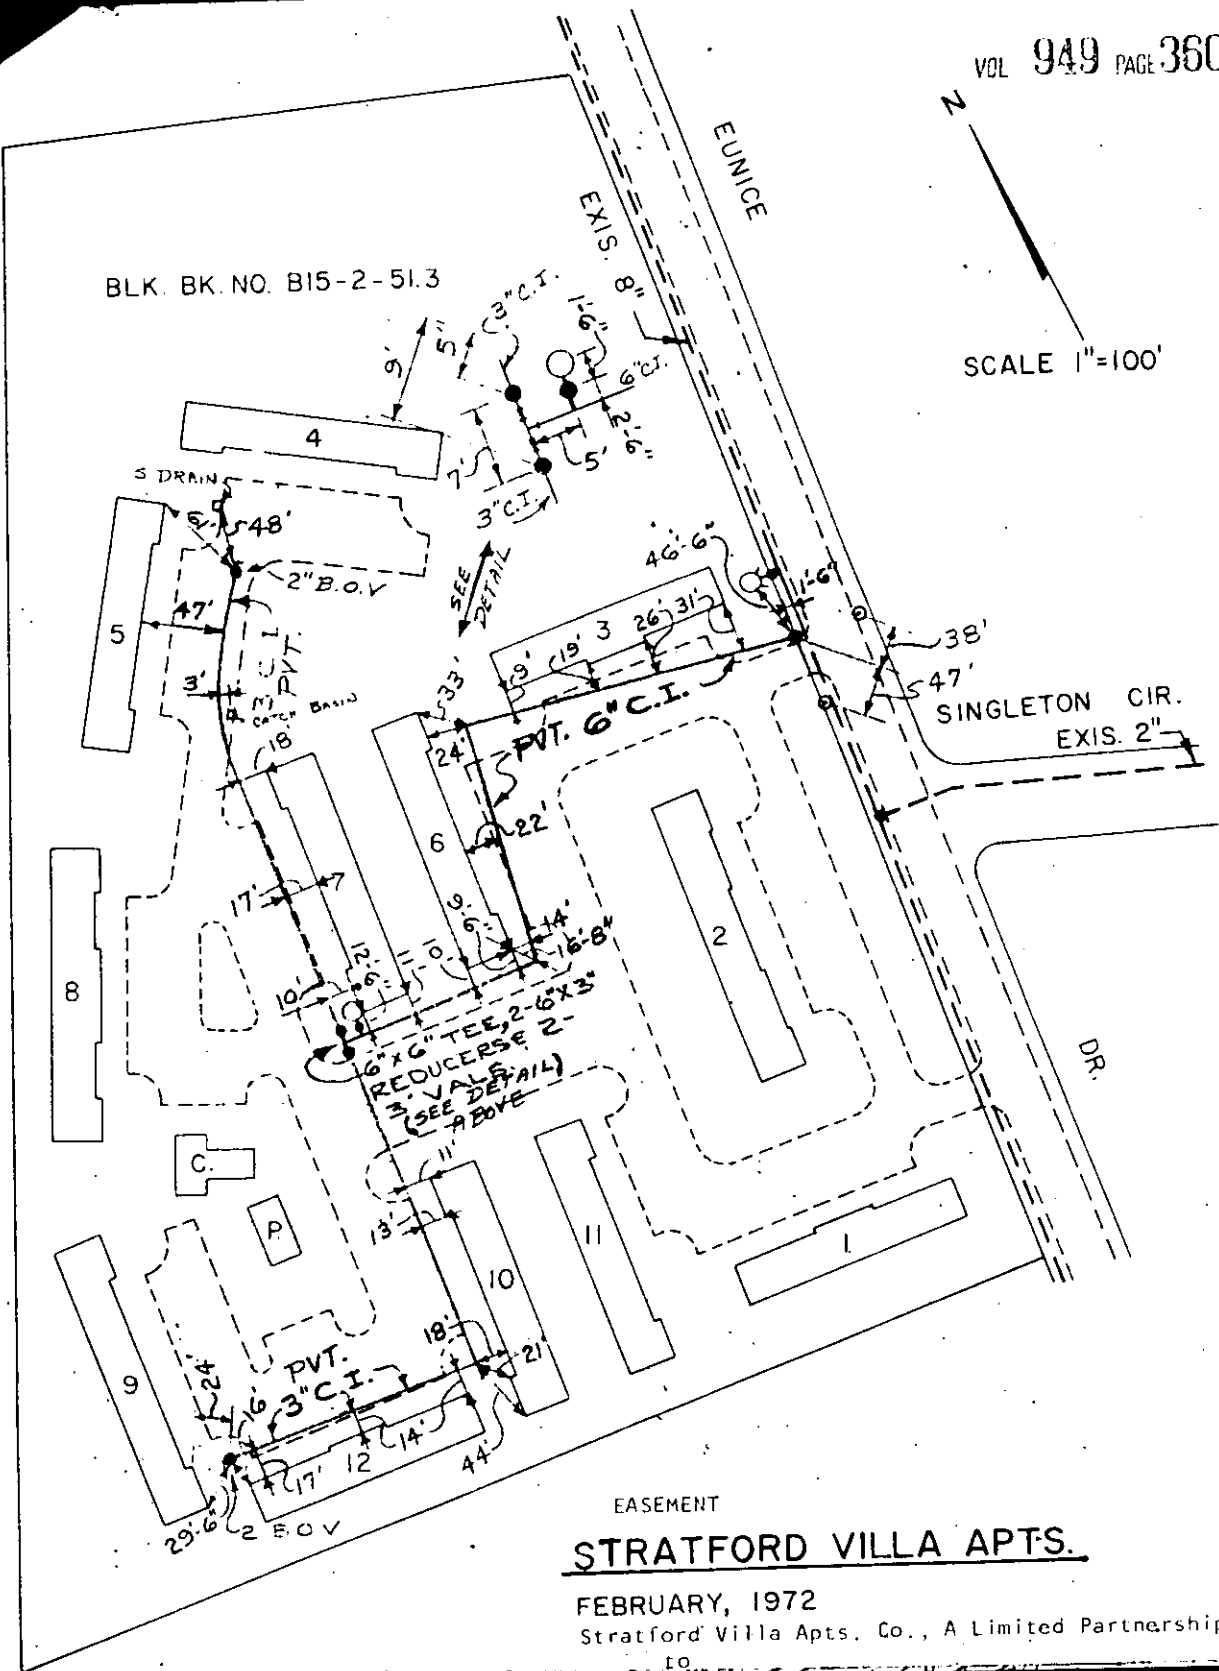

EASEMENT

STRATFORD VILLA APTS.

FEBRUARY, 1972

Stratford Villa Apts. Co., A Limited Partnership