


Material List:

1860' ±	-	8" Pipe
420' ±	-	6" Pipe
410' ±	-	2" Pipe
1	-	Fire Hydrant
3	-	6" Valves
2	-	2" Valves

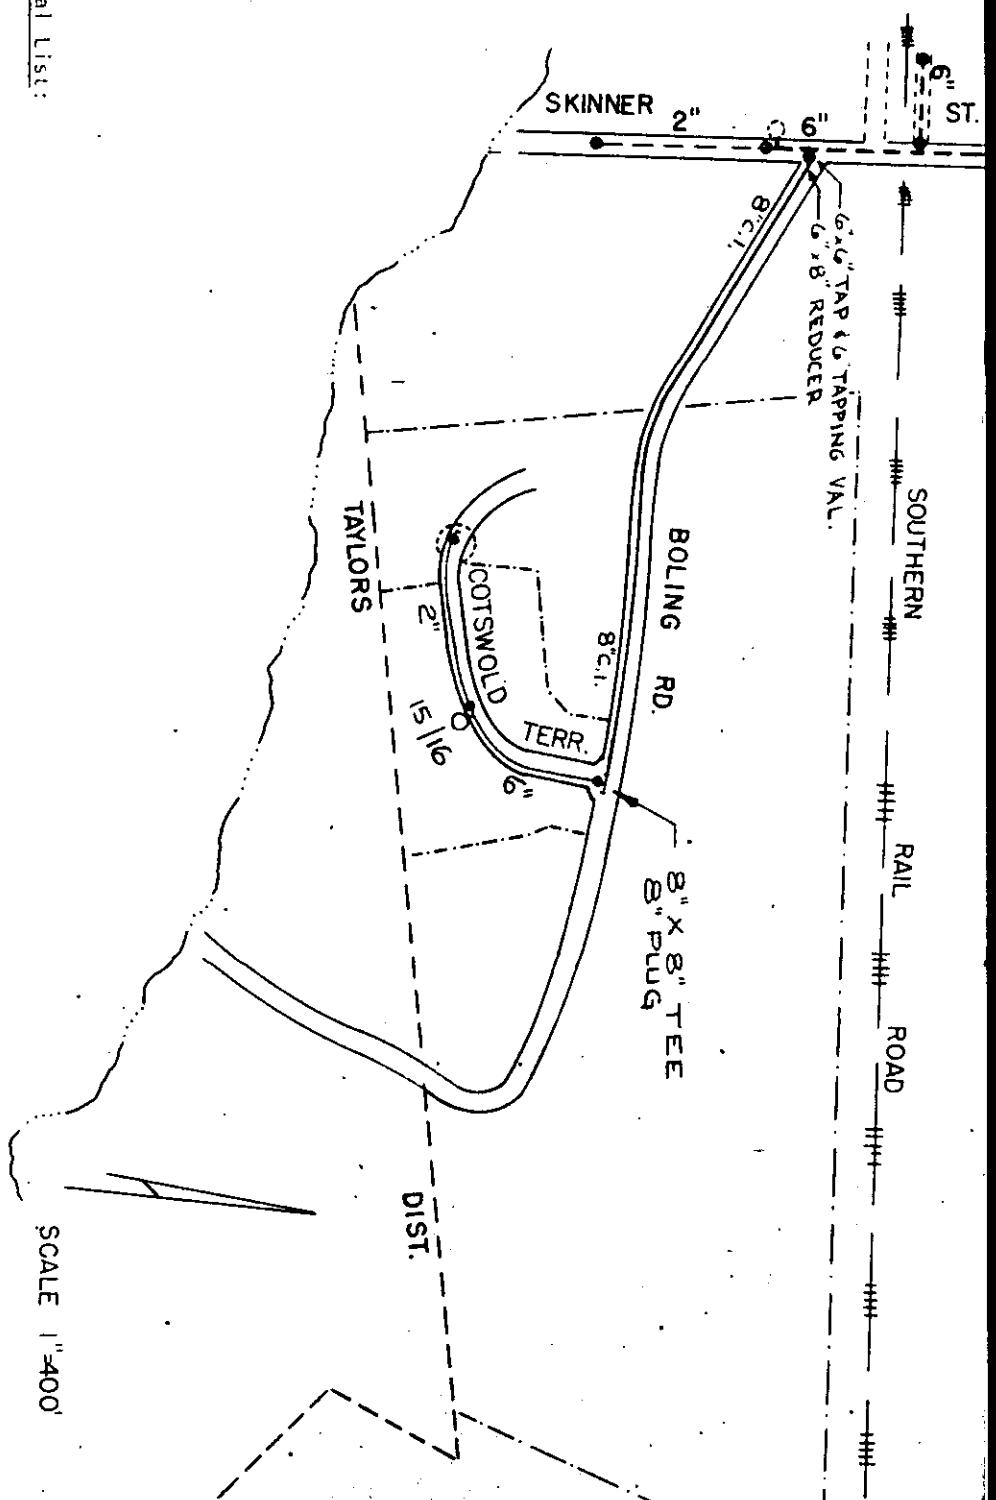

**OAKVIEW SUBD. - SEC. #1**

BLK. BOOK T-34-1-4  
MAY, 1972

Westminister Company  
to  
City of Greenville  
Aug. 29, 1972

Recorded September 22, 1972 At 3:52 P.M. #8859