


FILED
GREENVILLE CO. S. C.

VOL 959 PAGE 374

NOV 2 2 56 PM '72

ELIZABETH RIDDLE
R.M.C.

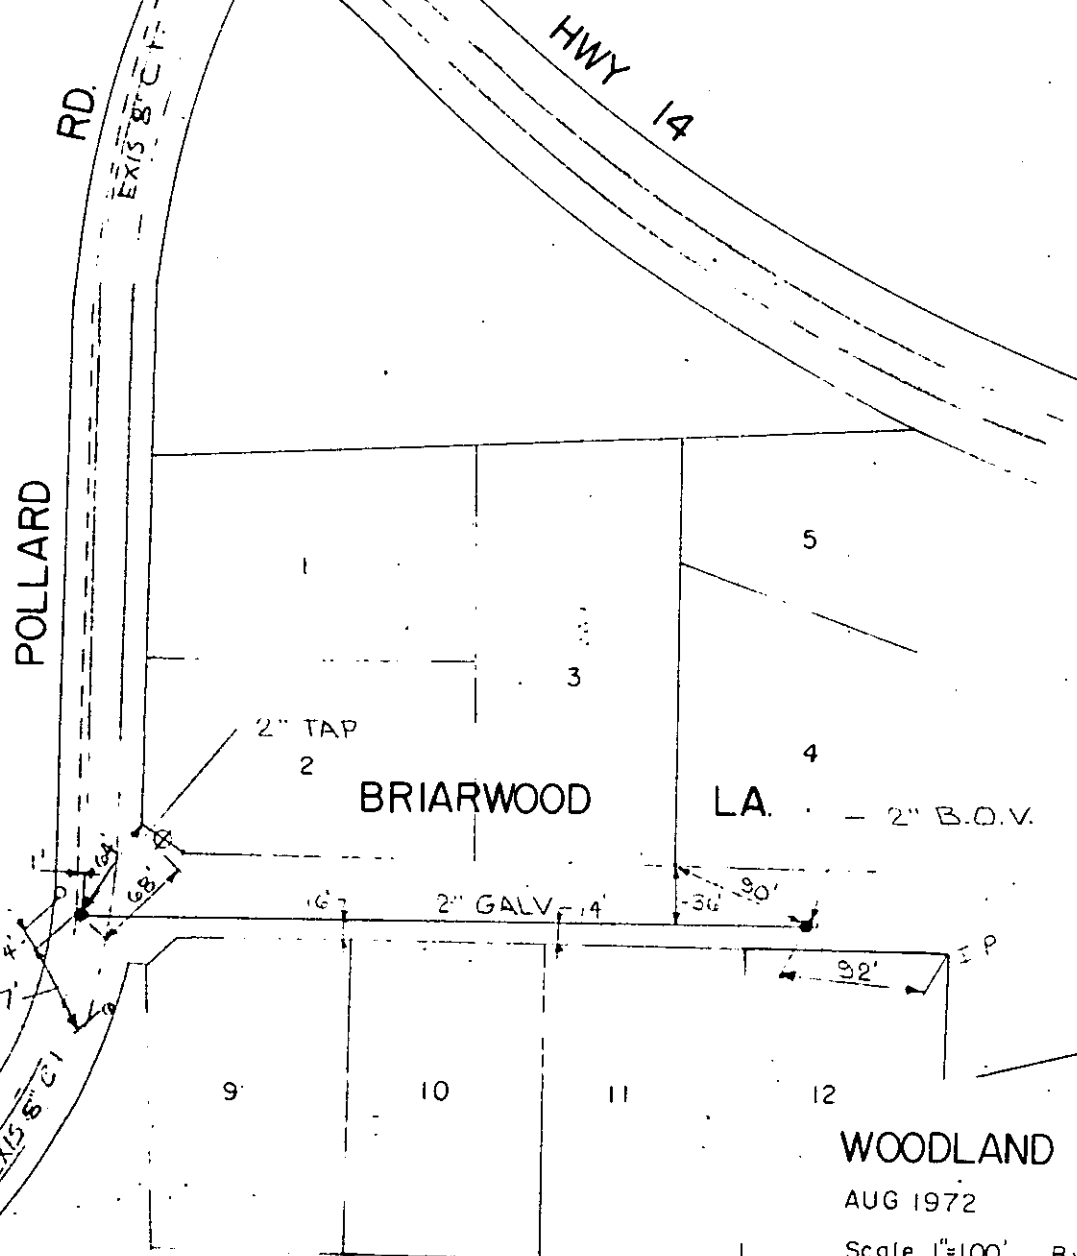

WOODLAND VILLAGE

AUG 1972

Scale 1"=100' By D.H.B.

Material List.

2" Pipe	-	450'
2" Valves	-	2

Alvin W. Green
& Jimmy P Langston
to

City of Greenville
October 13, 1972

Plat and Deed Recorded November 2, 1972 at 2:56 P. M., #13339