


51



KENDRICK, STEPHENSON & JOHNSON

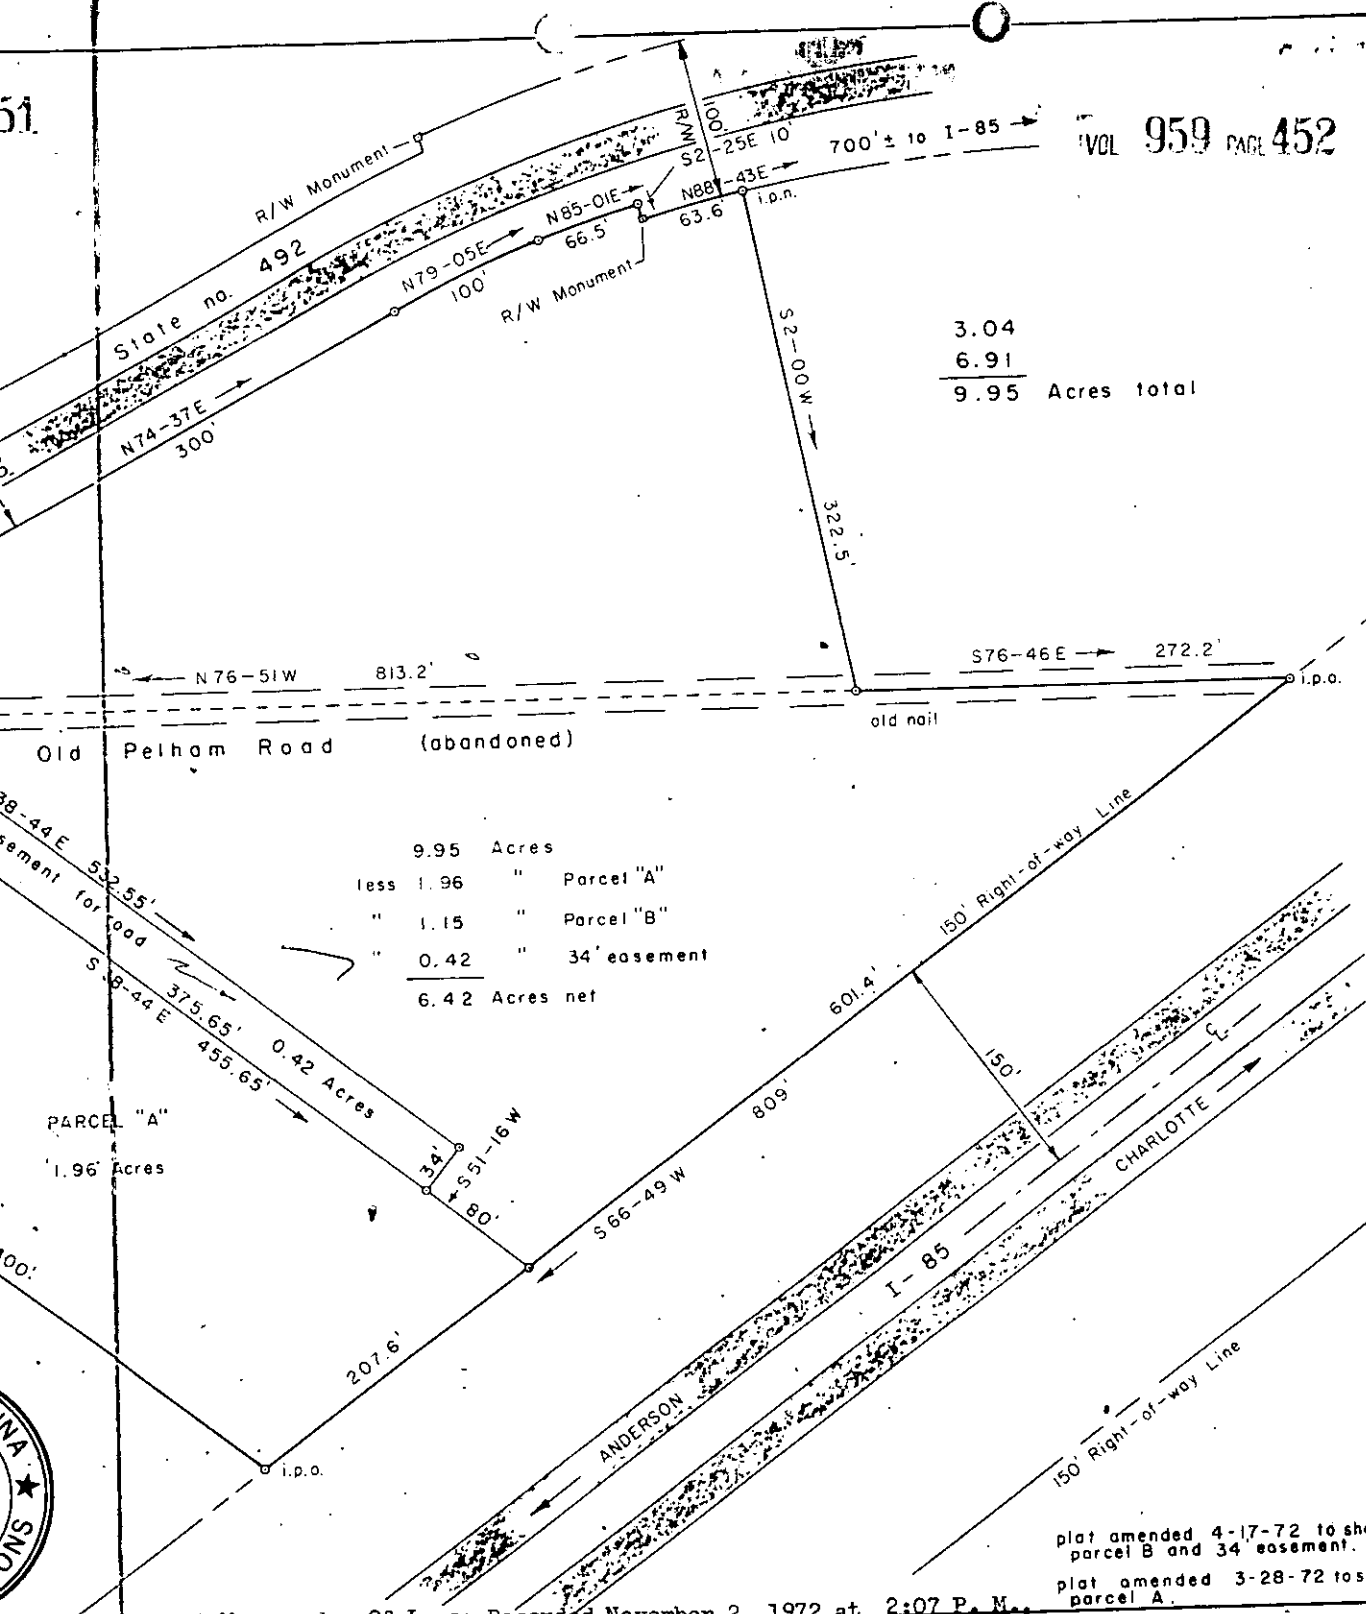

plat amended 4-17-72 to show parcel B and 34' easement.
plat amended 3-28-72 to show parcel A.

Plat & Memorandum Of Lease Recorded November 2, 1972 at 2:07 P. M.

13297