


N

SCALE 1"=100'

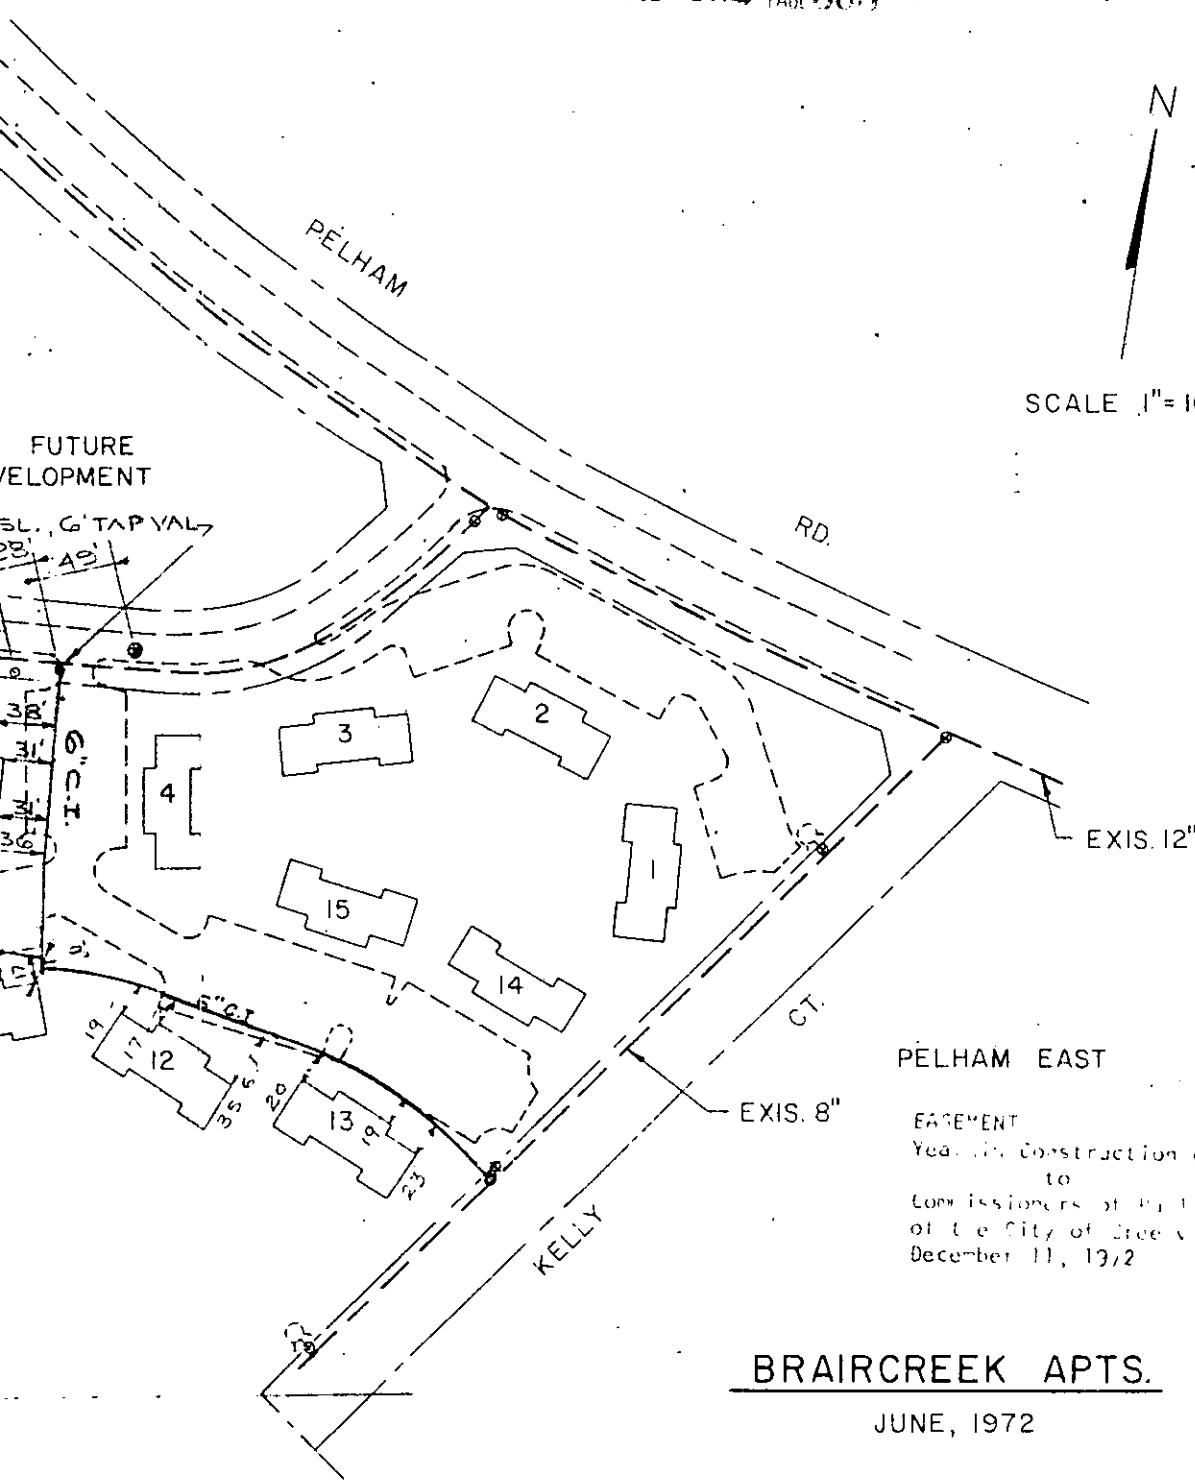

PELHAM EAST

EASEMENT  
 Yearlin Construction Company,  
 to  
 Commissioners of Public Works  
 December 11, 1972

BRAIRCREEK APTS.

JUNE, 1972

Plat and Deed Recorded December 13, 1972 at 2:18 P.M., # 17264