


SCALE 1" = 100'

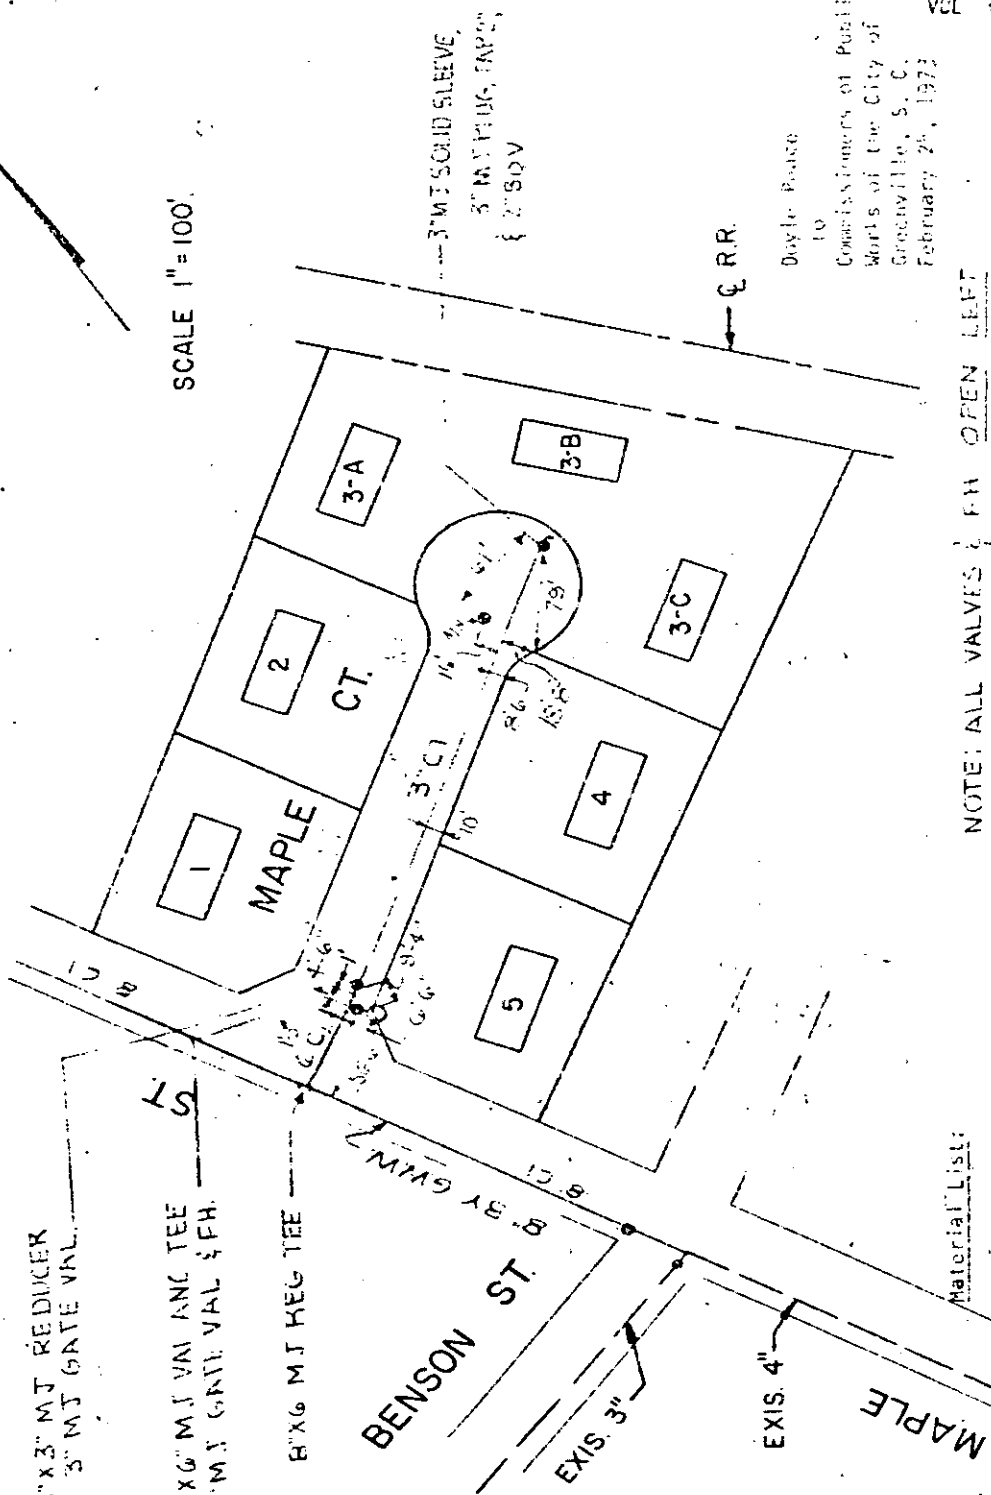

1/2" x 3" MJ REDUCER  
 { 3" MJ GATE VAL.  
 6" x 6" MJ VMI ANG TEE  
 6" MJ GATE VAL & FH.  
 8" x 6" MJ REG TEE

3" MJ SOLID SLEEVE,  
 3" MJ TEE, CAP,  
 { 2" SDV

Doyle House  
 to  
 Commissioners of Public  
 Works of the City of  
 Greenville, S. C.  
 February 7<sup>th</sup>, 1973

NOTE: ALL VALVES & F.W OPEN LEFT

Material List:

6" Pipe	60'
3" Pipe	320'
6" Valve	-
3" Valve	-
2" Valve	-
Fire Hydrant	-

Maple Properties, a Partnership,  
 BY: Ronald E. Gregory  
 DOYLE, PEACE  
 NOVEMBER, 1972  
 BLK PKG NO 200-1-1  
 PPT OF 300-1-1

Plat Recorded April 2nd, 1973 at 2:58 P. M. #27718