


THREATT-MAXWELL PROPERTIES

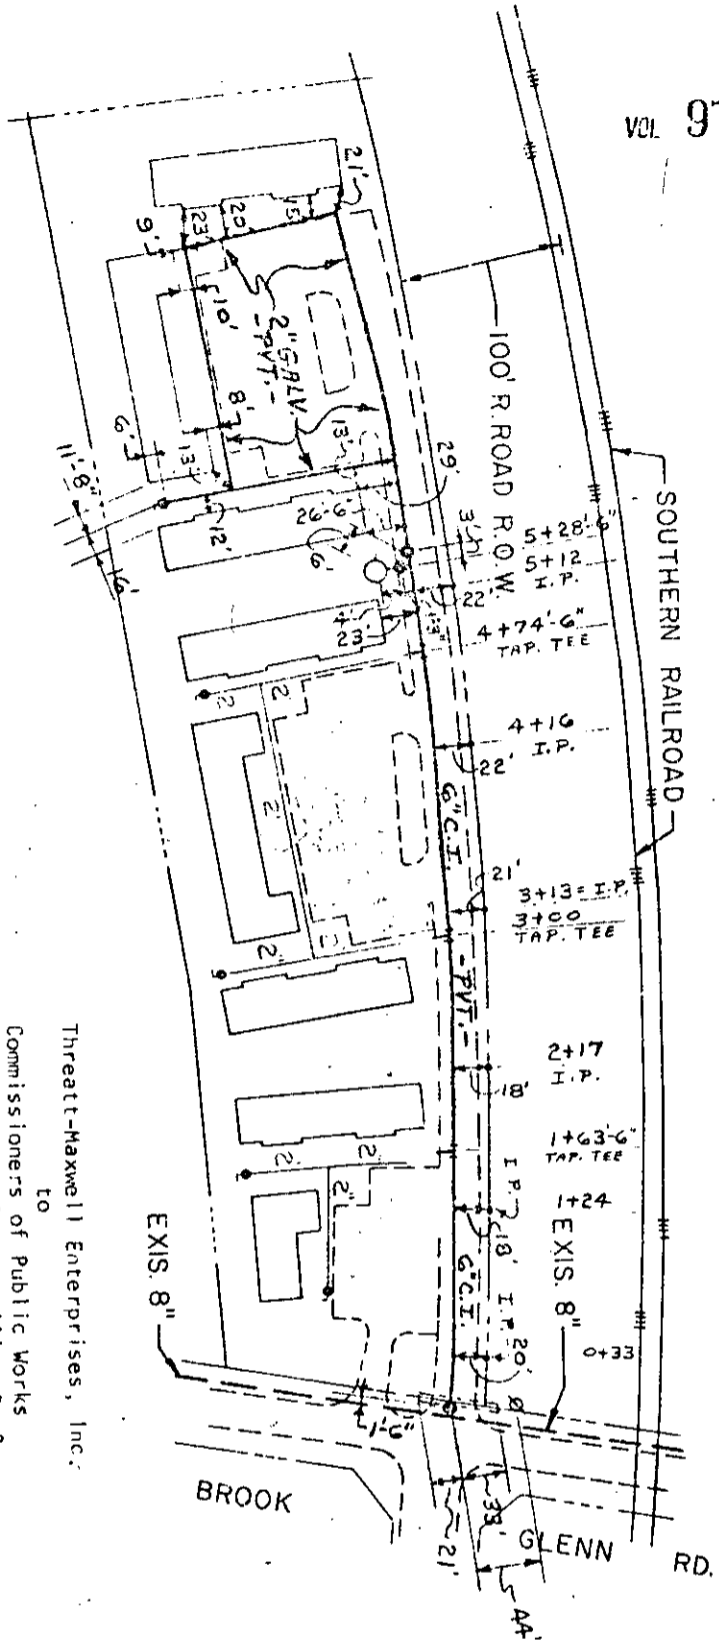

SCALE 1"=100'



Threatt-Maxwell Enterprises, Inc.
 to
 Commissioners of Public Works
 of the City of Greenville, S. C.
 April 4, 1973
 EASEMENT

BROOK GLENN APTS.
 PT. OF PLK. B. T2-4-2

Plat Recorded April 18, 1973 at 9:53 A. M., # 29522