


939/215

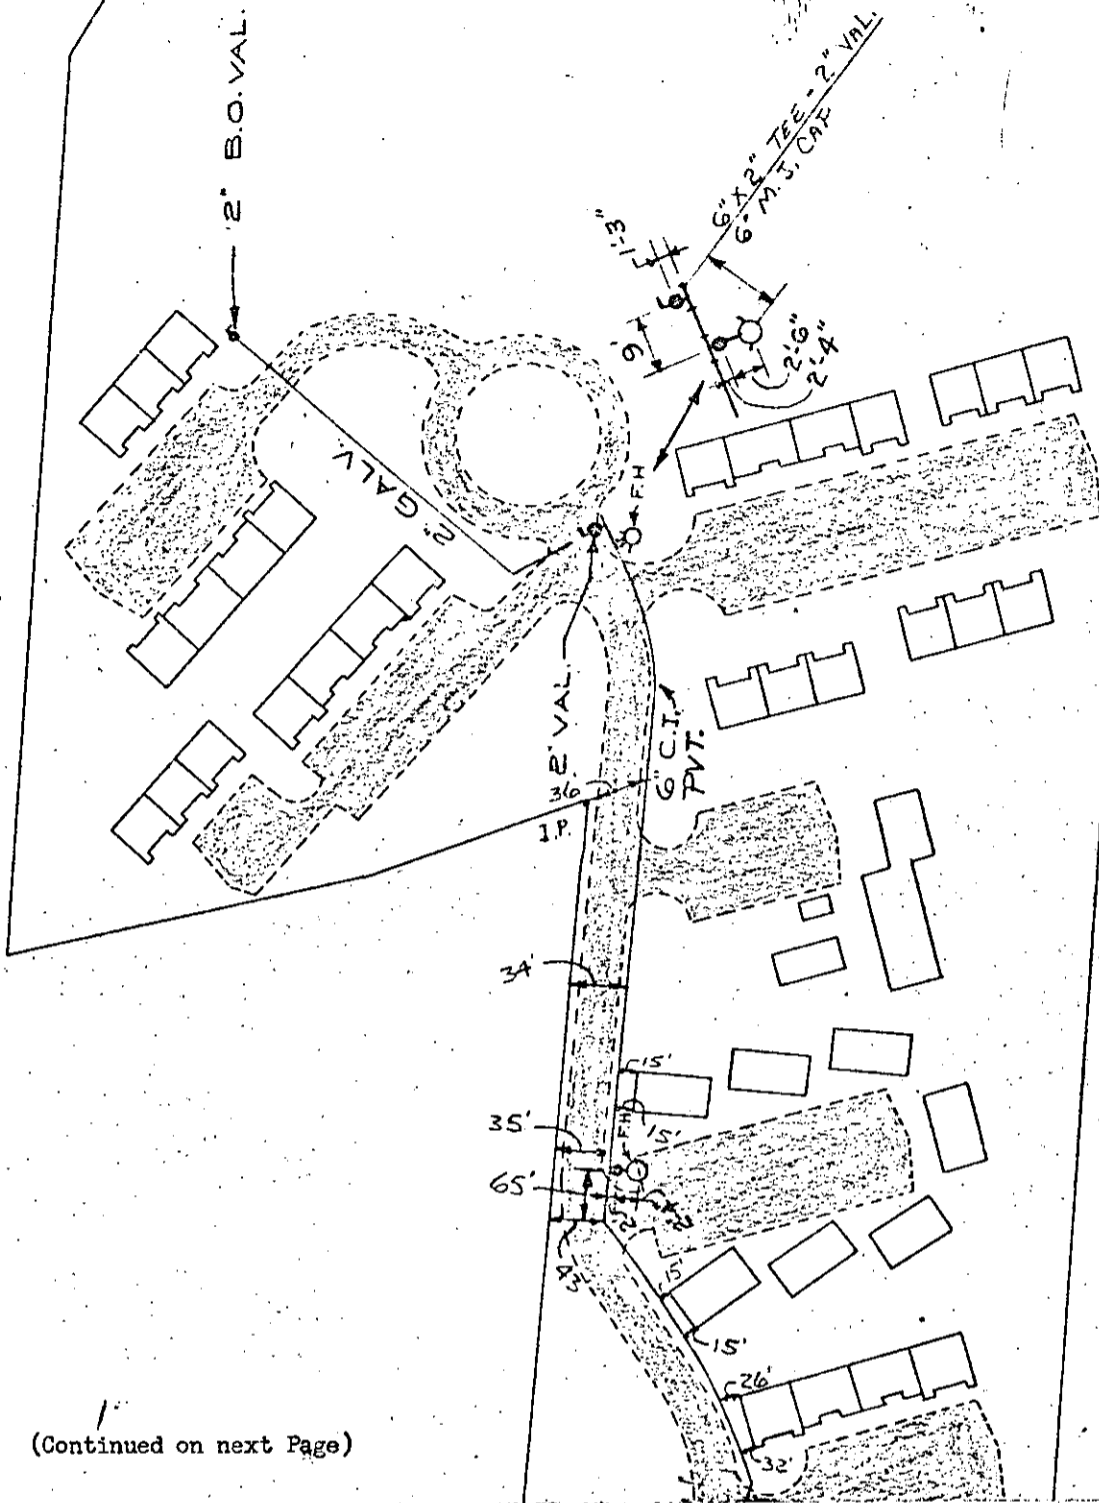

(Continued on next Page)

WHITE HORSE MANOR ASSOCIATES
a limited partnership

WHITE HORSE MANOR APTS.

JULY, 1971 - BLK. B. NO. B133-1-10.4

R. Street, A Partnership
to
City of Greenville
Easement
June 22, 1972