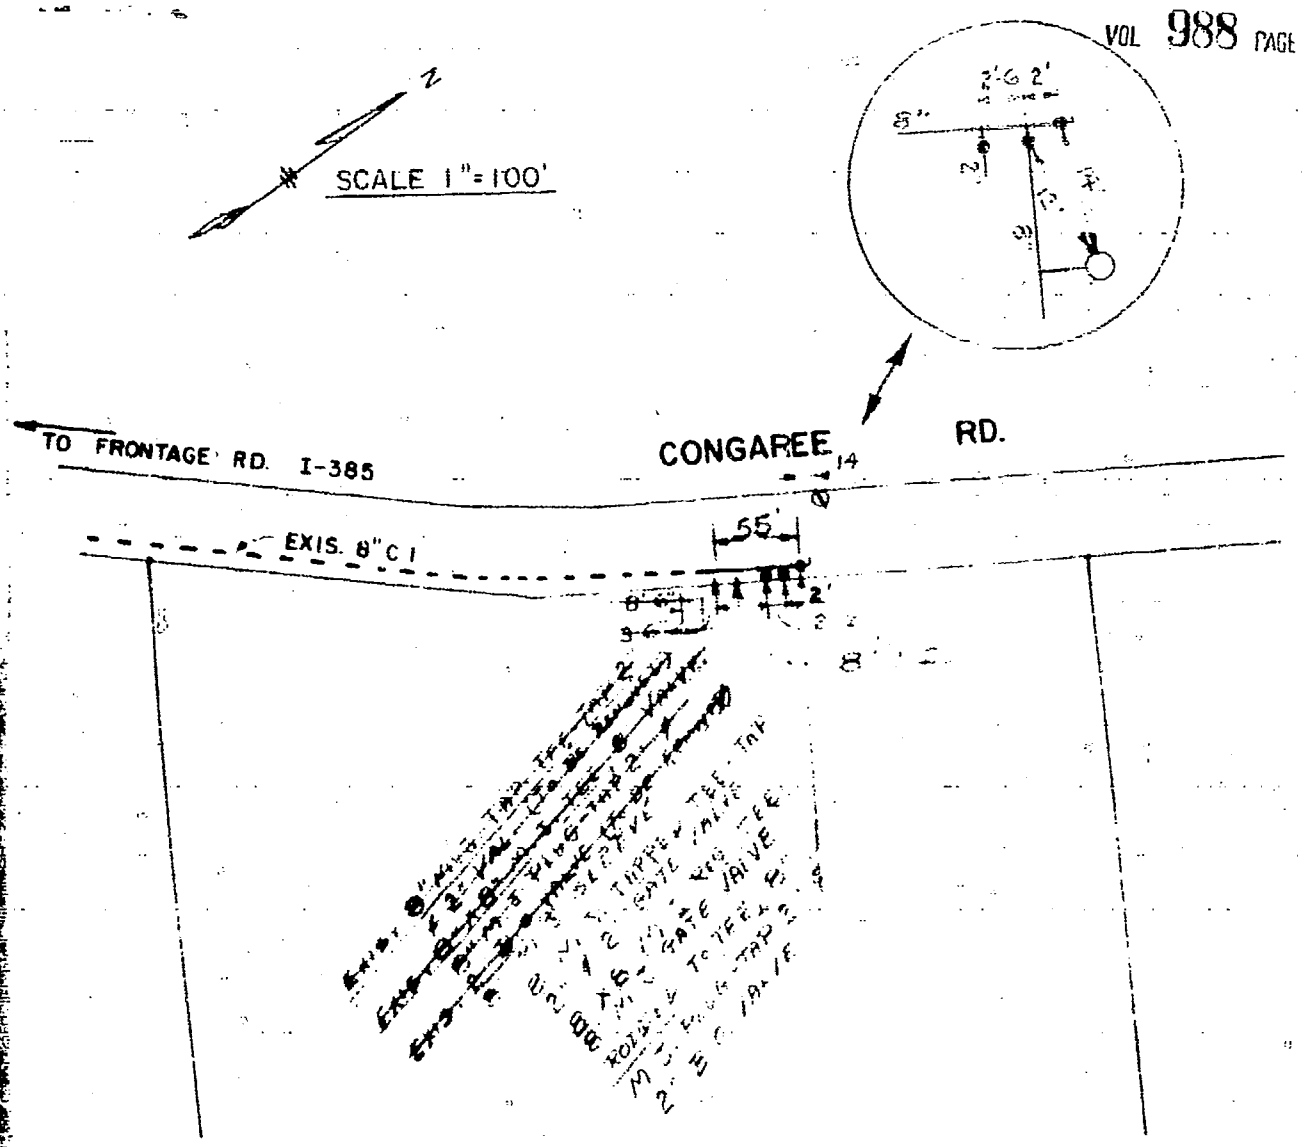

CONGAREE RD.

JULY, 1973

Material List:

55'± 8" C. I. Pipe

Grantland Realty, Company
to
Commissioners of Public Works
of the City of Greenville, S. C.
October 23, 1973

RECORDED NOV 13 '73 12961