


W 5 P 6

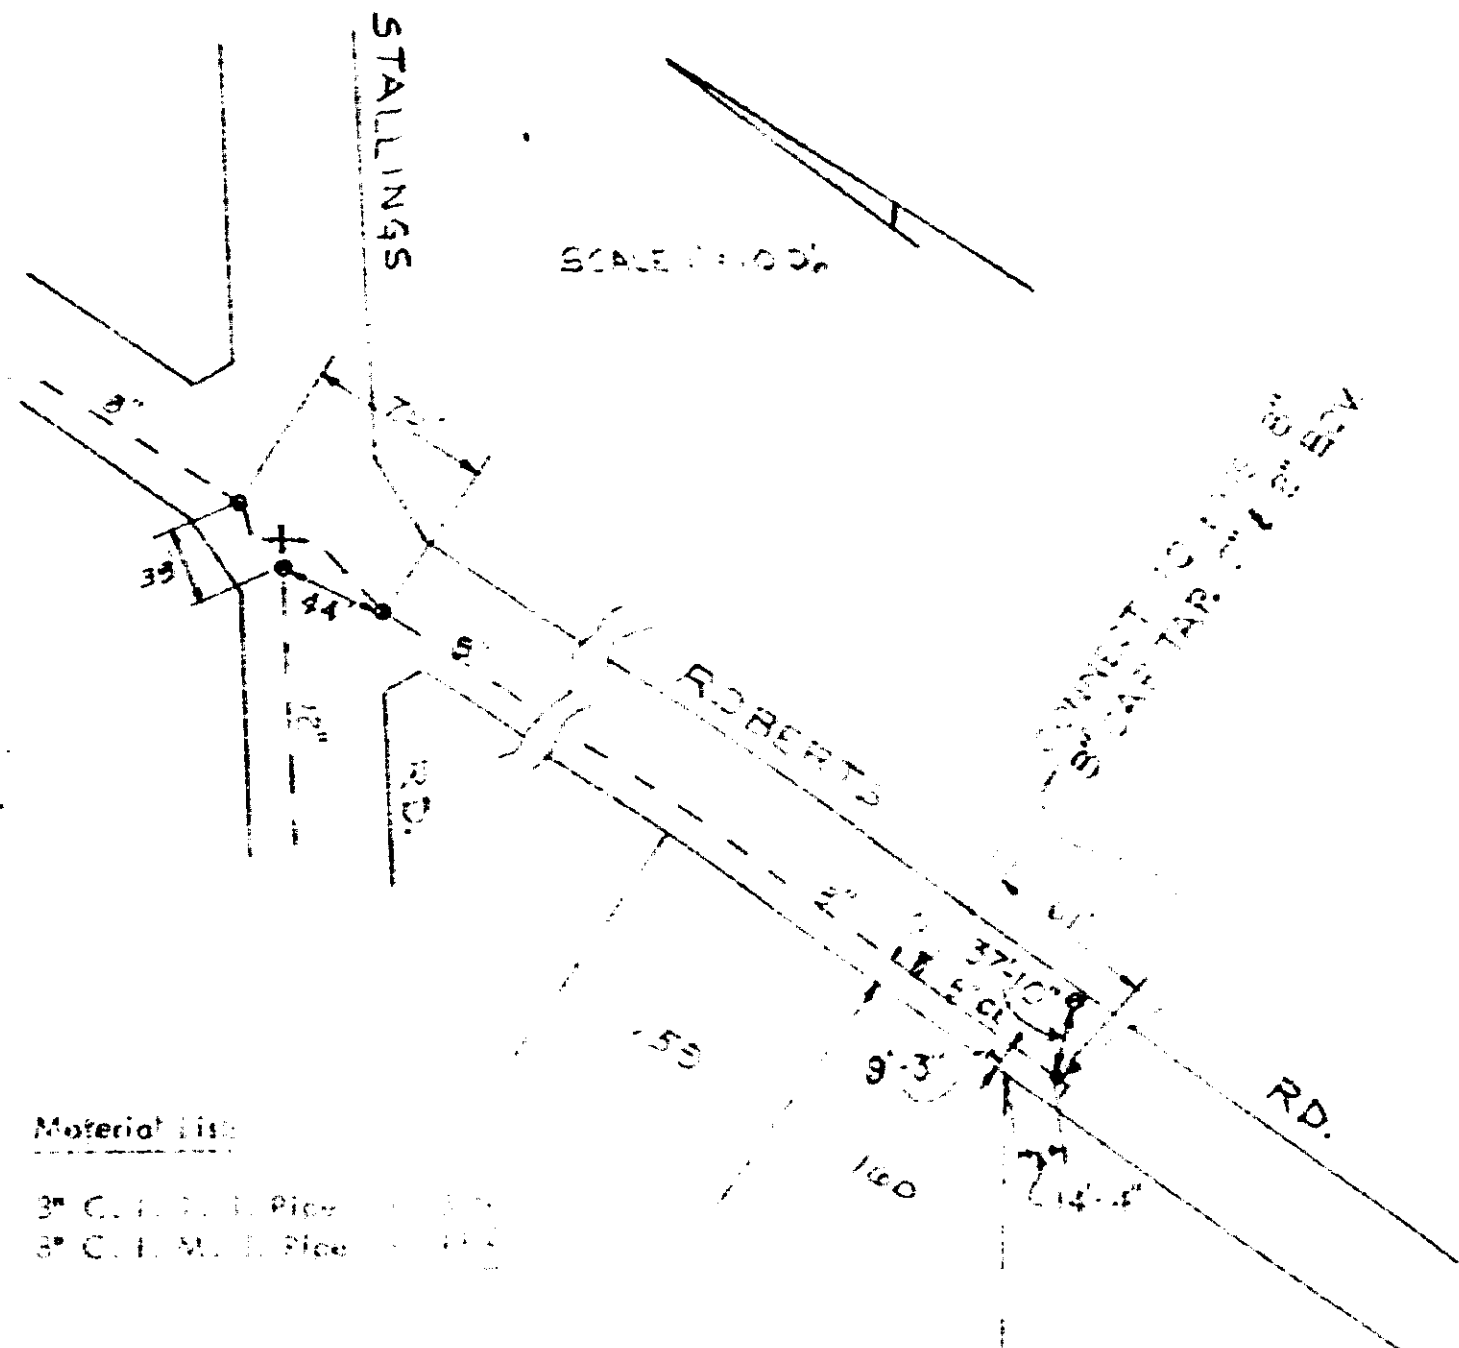

Material List:

- 3" C. I. D. I. Pipe - 30'
- 3" C. I. M. I. Pipe - 115'

Mr. Freddie Sellman
 to
 Commissioners of Public Works
 of the City of Greenville, S. C.
 February 13, 1974
 RIK: B P. or 26.2-1-111

ROBERTS RD.

RECORDED MAR 5 '74 21875

4928 R.R.