


"EXHIBIT A"

6083

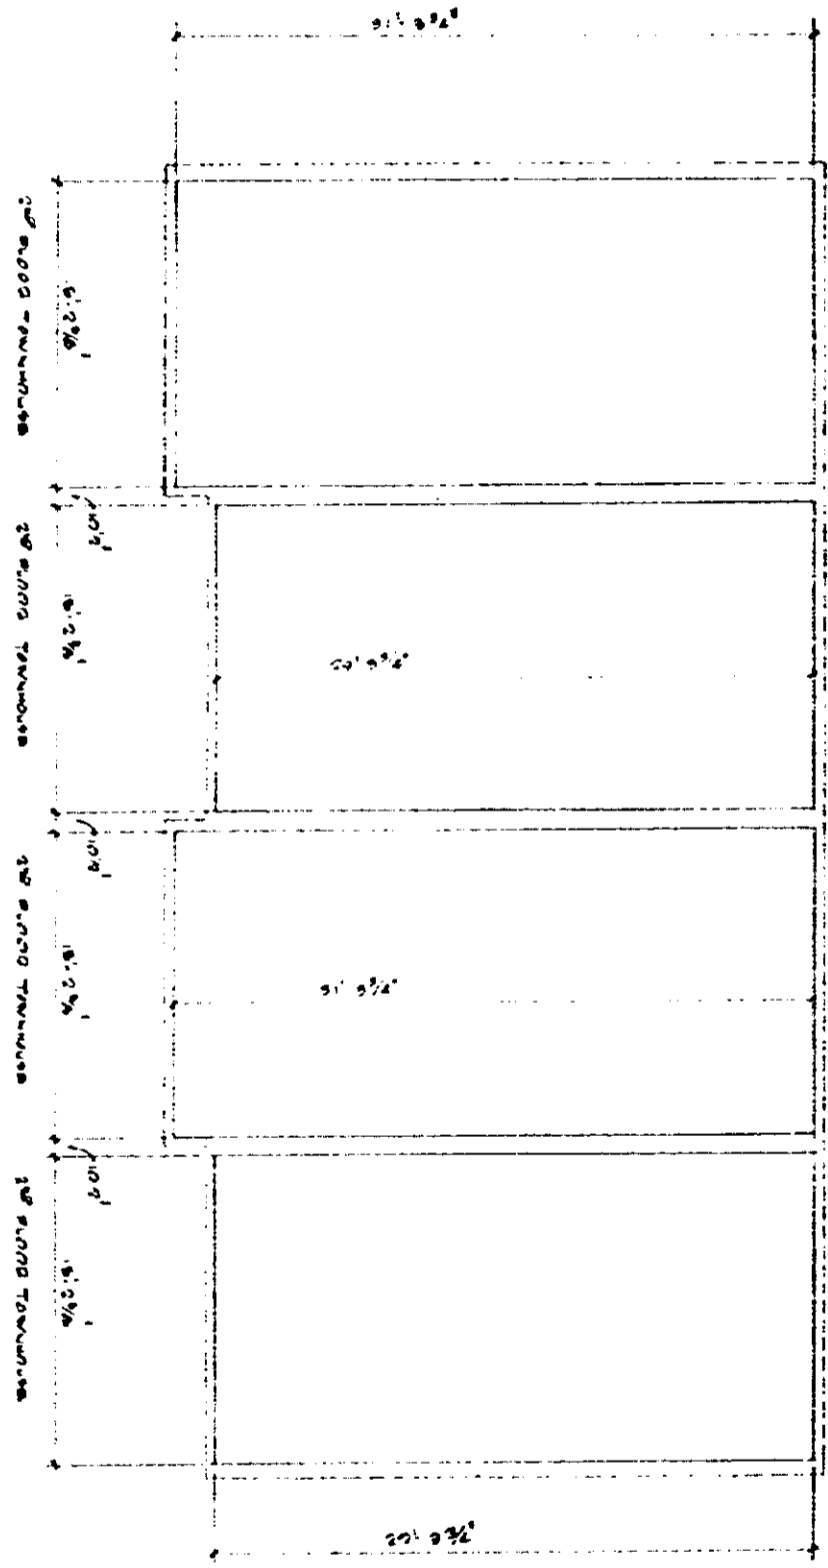







