



Vol 999 PAGE 597

"EXHIBIT A"

Page Two of Three Pages

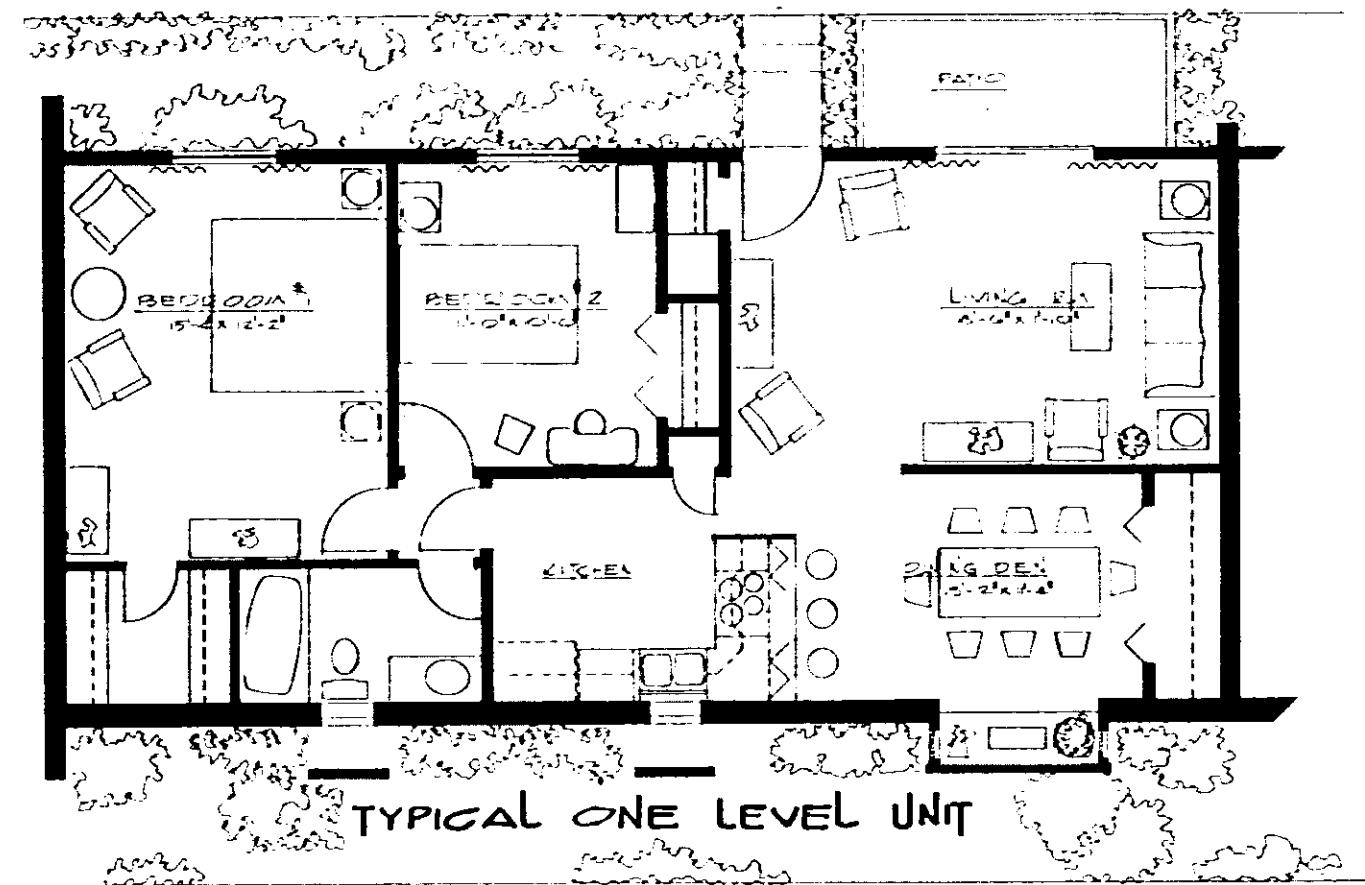

ARCHITECTS CERTIFICATE  
I, JOE W. HILLER, HEREBY CERTIFY  
THAT THIS PLAN SHOWS THE INTERIOR  
OF THE BUILDING AND IS TRUE AND COR-  
RECT TO THE BEST OF MY KNOWLEDGE.  
DATED THE 23 DAY OF MAY, 1974  
SIGNED *Joe W. Hiller*  
REGISTERED ARCHITECT NO 658 S. C.

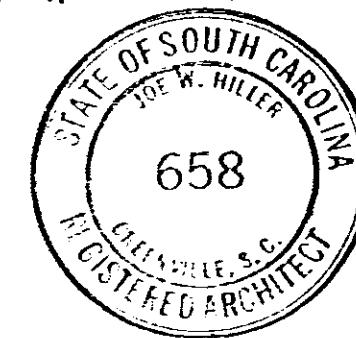

4328 RV-2