


670

8234 RV-2

SALUDA RIVER VOL 999 PAGE 670

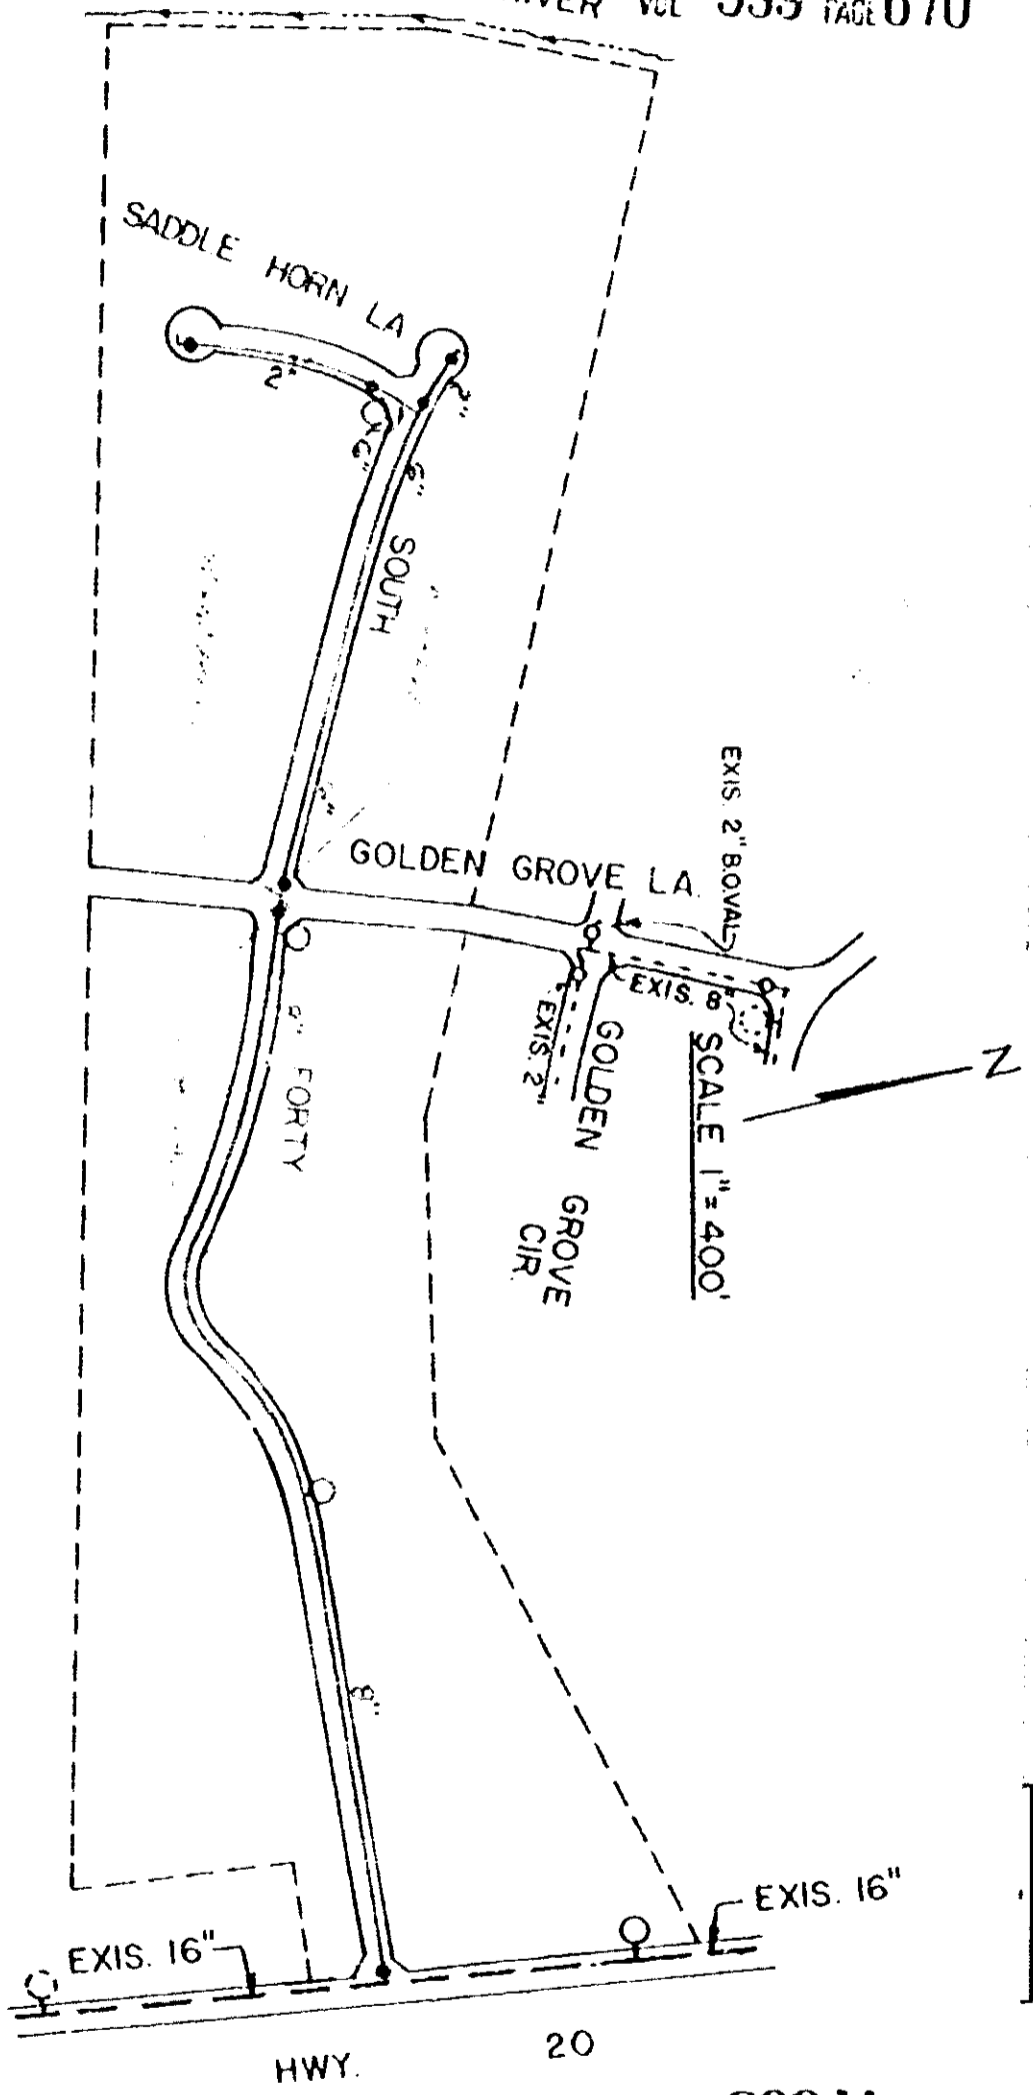

Material List:

8" C. I. Pipe	2,225'±
6" C. I. Pipe	1,060'±
2" Galv. Pipe	570'±
Fire Hydrants	3
8" Valves	2
6" Valves	4
2" Valves	4

NOTE
 ALL 6" & 8" VALVES OPEN RIGHT
 ALL FIRE HYDRANTS OPEN RIGHT
 ALL 2" VALVES OPEN LEFT

① Revised: November, 1972
 ② Revised: November, 1973
 REMISED: MAY, 1974
 BUK. B. 615.5-1-6

SOUTH FORTY

NOVEMBER, 1972

Pension Plan and Trust of
 L & P Enterprises, Inc.
 to
 Commissioners of Public Works
 of the City of Greenville, S. C.
 May 14, 1974

HWY. 20
 EXIS. 16" EXIS. 16" EXIS. 16"
 29941
 RECORDED MAY 27 '74