


SCALE 1" = 400'

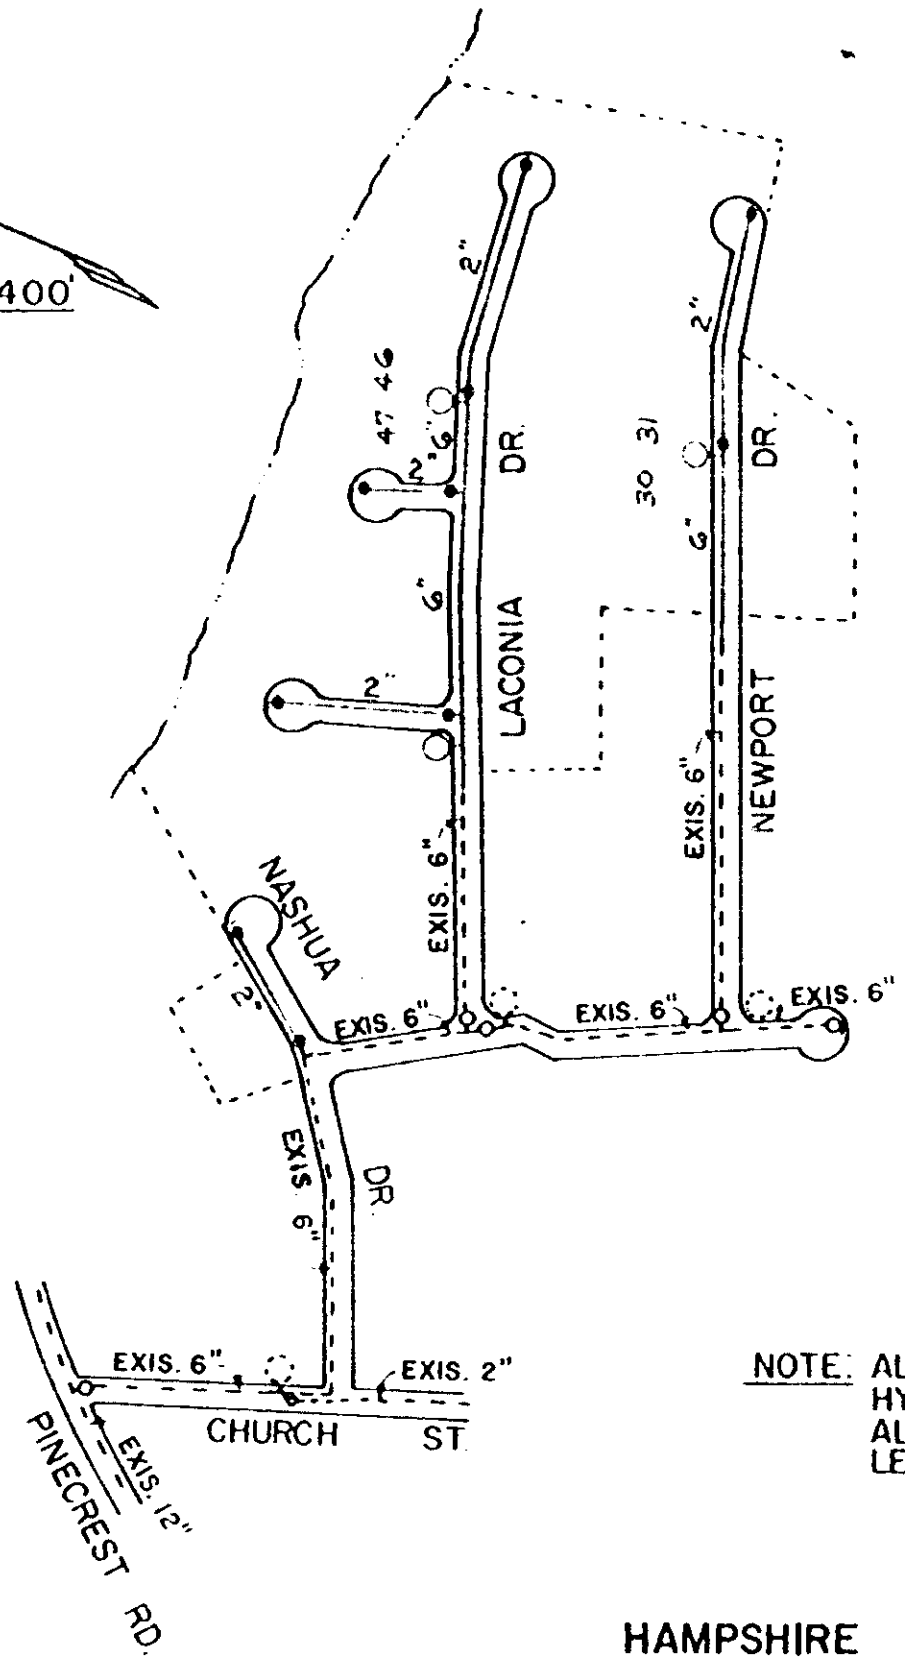

VOL 1002 PAGE 815

NOTE: ALL 6" VALS. & FIRE HYDS. (OPEN RIGHT)
ALL 2" VALS. (OPEN LEFT)

HAMPSHIRE HILLS, SEC. 2
MAY, 1974

Material List:

| | | |
|---------------|---|---------|
| 6" C. I. Pipe | - | 1,100'± |
| 2" Galv. Pipe | - | 1,685'± |
| 6" Valves | - | 3 |
| 2" Valves | - | 8 |
| Fire Hydrants | - | 3 |

Williams Builders, Inc.
to
Commissioners of Public Works
of the City of Greenville, S. C.
July 5, 1974
(BLK. B 477-1-1)

RECORDED JUL 11 '74 1116

4328 RV-2

0812